


N-064
write/rain


OFFICE OF THE
DOUGLAS COUNTY SURVEYOR

Station: N 669
Date Set: 1975
Set By (Agency): OSHD
Date Recovered: 1/21/93
Recovered By: SJF, RWS

T 26 S, R 6 , Sec 25

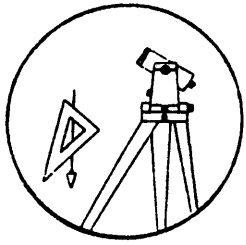

- Found
- Reset
- Referenced
- New
- Not Found
- Destroyed

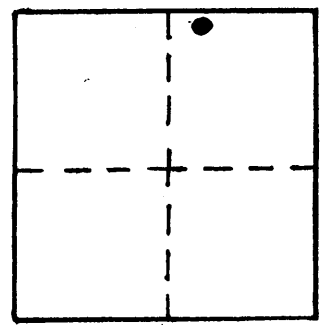

VERTICAL CONTROL

Elevation: ~~529.00~~ * NGS Line # _____ USGS Line # _____ OSHD Line # _____
Precision: ~~3 ft~~ Agency: DCSO Proj. # 2007 Date: 1992

HORIZONTAL CONTROL

South Zone O.C.S. 27: Y(Northing) _____ X(Easting) _____
South Zone O.C.S. 83: Y(Northing) _____ X(Easting) _____
Precision: _____ Agency: _____ Proj. # _____ Date: _____
Approx. NAD 83 Geographic Position: Latitude _____ Longitude _____

DESCRIPTION and TO REACH

A 3 INCH DIAMETER OSHD CAP STAMPED "N 669 1975" SET FLUSH IN CONCRETE CURBING OF DEL RIO RD OVERCROSSING OF INTERSTATE HIGHWAY 5.

MONUMENT IS 0.05 MILES WEST FROM INTERSECTION OF DEL RIO Rd. (CO. RD. #115) AND OLD STATE HIGHWAY 99 NORTH IN T26S, R6W, SECTION 25.

* NOTE: 5/29/03 ODOT REPORT STATES ELEVATION NOT GOOD DUE TO BRIDGE RAISING

Reference Marks:

