



OFFICE OF THE  
DOUGLAS COUNTY SURVEYOR  
**N-065**

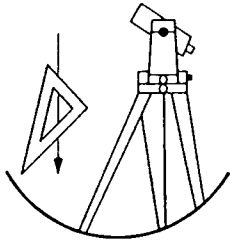

Station: N 739  
 Date Set: 1987  
 Set By (Agency): NGS  
 DCSO Designation: N-065  
 Date Recovered: 8-1993  
 Recovered By: RWS SJF  
 Date Recovered: \_\_\_\_\_  
 Recovered By: \_\_\_\_\_  
 Date Recovered: \_\_\_\_\_  
 Recovered By: \_\_\_\_\_

T23S R5W Sec. 33

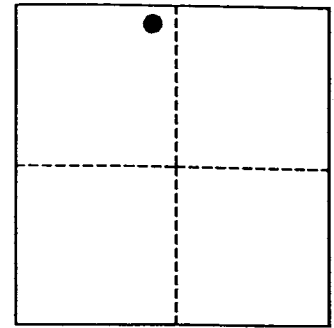

**VERTICAL CONTROL**

~~NAVD 88~~  
~~NGVD 29~~ Elevation: 530.400 FEET      NAVD 88 Elevation: 161.666 METERS  
 NGS Line # L25035    USGS LINE # \_\_\_\_\_    OSHD Line # \_\_\_\_\_    FILE # \_\_\_\_\_  
 Precision: 1ST ORDER    Agency: NGS    Proj: \_\_\_\_\_    Date: 1988

**HORIZONTAL CONTROL**

O.C.S. 27    Y(Northing): \_\_\_\_\_    O.C.S. 83    Y(Northing): 692678  
 (South Zone)    X(Easting): \_\_\_\_\_    (South Zone)    X(Easting): 4179656  
 Precision: GIS SCALED    Agency: DCSO    Proj: \_\_\_\_\_    Date: 2014  
 Approx. O.C.S. 27 Geographic Position:    Latitude: 43°31'59"    Longitude: 123°17'46"  
 Approx. O.C.S. 83 Geographic Position:    Latitude: \_\_\_\_\_    Longitude: \_\_\_\_\_

Found: A 9/16 inch diameter stainless steel rod set under a 6 - 3/8 inch diameter aluminum collar and access cover set in concrete, access collar stamped "N 739 1987" flush with ground.

To reach: From the intersection of I-5 and the Rice Hill exit (exit #148) in T23S R5W Sec28 exit 148. Proceed southerly along I-5, 0.45 miles to monument on right, mile post 148.1

