

OFFICE OF THE  
DOUGLAS COUNTY SURVEYOR

Station: NEWIDGE

T 27 S, R 3W, Sec 11



Date Set: 1999

Set By (Agency): UNKNOWN

Date Recovered: JULY 1, 1999

Recovered By: RNS SIF

- |                                     |   |
|-------------------------------------|---|
| <input type="checkbox"/> Found      | <input checked="" type="checkbox"/> New |
| <input type="checkbox"/> Reset      | <input type="checkbox"/> Not Found      |
| <input type="checkbox"/> Referenced | <input type="checkbox"/> Destroyed      |

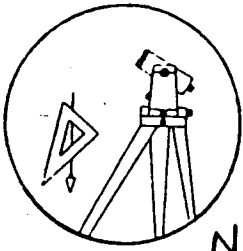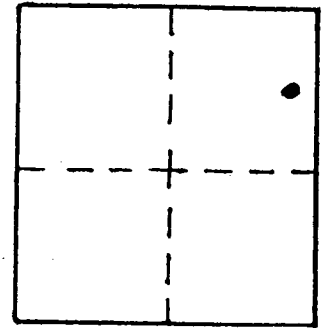

N-071

VERTICAL CONTROL

Elevation: 903.72 NGS Line # \_\_\_\_\_ USGS Line # \_\_\_\_\_ OSHD Line # \_\_\_\_\_

Precision: 3rd Agency: DCSO Proj. # 2007 Date: 1999

HORIZONTAL CONTROL CORPSCON6 NAVDBB 907.32 FT. CS 66/56

South Zone O.C.S. 27: Y(Northing) \_\_\_\_\_ X(Easting) \_\_\_\_\_

South Zone O.C.S. 83: Y(Northing) 582836 X(Easting) 4251962

Precision: GIS SCALED Agency: DCSO Proj. # \_\_\_\_\_ Date: 2014

Approx. <sup>OCSE 27</sup> ~~NAD 83~~ Geographic Position: Latitude 43°14'19" Longitude 123°00'40"

DESCRIPTION and TO REACH

A 2 1/2 INCH DIAMETER DISK OF UNKNOWN ORIGIN STAMPED "DCSO NEWIDGE 1999" SET FLUSH IN TOP OF CONCRETE ABUTMENT WALL AT SOUTHWESTERLY CORNER OF BRIDGE OVER CAVITT CREEK. MONUMENT IS ALSO FLUSH WITH ROAD SURFACE (COULD BE HIDDEN IN FUTURE BY ASPHALT OVERLAYMENT).

FROM THE INTERSECTION OF LITTLE RIVER ROAD (Co. Rd. #17C) AND NEW BRIDGE ROAD (Co. Rd. 82A) IN T27S, R3W, SEC. 11 PROCEED SOUTHWESTERLY ALONG NEW BRIDGE ROAD APPROXIMATELY 300 FEET TO SOUTH END OF BRIDGE OVER CAVITT CREEK AND MONUMENT ON RIGHT.

Reference Marks:

