

Douglas County Geodetic Data Sheet


T 29 R 05 WS 28 C

Station: ~~09642~~ 612 B=09

Designation: 6/-148

Date Set: 1903 Set By (Agency): USGS

Last Date Recovered: 08/00/1993

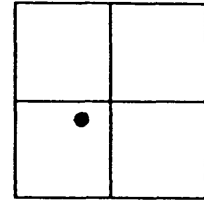

VERTICAL CONTROL

NGVD 29 Elevation: 613.526 Feet

Precision: 1ST ORDER Agency: USC&GS

CS File: LINE 6

Date: 1956

NAVD 88 Elevation: 188.050 Meters

Precision: 1ST ORDER Agency: NGS

CS File: L25042

Date: 1988

HORIZONTAL CONTROL

OCS 27 Y(Northing): X(Easting): Lat Long:

Precision: Agency: CS File: Date:

OCS 83 Y(Northing): 505458 X(Easting): 473187 Lat Long:

Precision: 615 SCALED Agency: DCSO CS File: Date: 2014

OCS 83/91 Y(Northing): X(Easting): Lat Long:

Precision: Agency: CS File: Date:

OCS 83/98 Y(Northing): X(Easting): Lat Long:

Precision: Agency: CS File: Date:

Scaled Lat 43° 01' 09" Long: 123° 17' 47"

Description:


FOUND A 3.75 INCH DIAMETER DISK ON A 3.5 INCH DIAMETER IRON PIPE STAMPED; 09 612B 1903; PROTRUDING 2 INCHES ABOVE GROUND.

Comments:

FROM THE INTERSECTION OF SOUTH MAIN ST.; OLD PACIFIC HWY 99 AND WESTERN AVE. IN T29S R5W SEC. 28 MYRTLE CREEK; PROCEED WESTERLY ALONG WESTERN AVE. APPROX. 0.2 MILES TO MONUMENT ON LEFT AT OLD RAILROAD STATION; OLD CONCRETE FOUNDATION STILL VISIBLE.

Notes:

MONUMENT ALSO KNOWN AS 612 B = 09. ELEVATION CHANGED BACK TO USGS 1ST ORDER ELEVATION 4/21/2003.

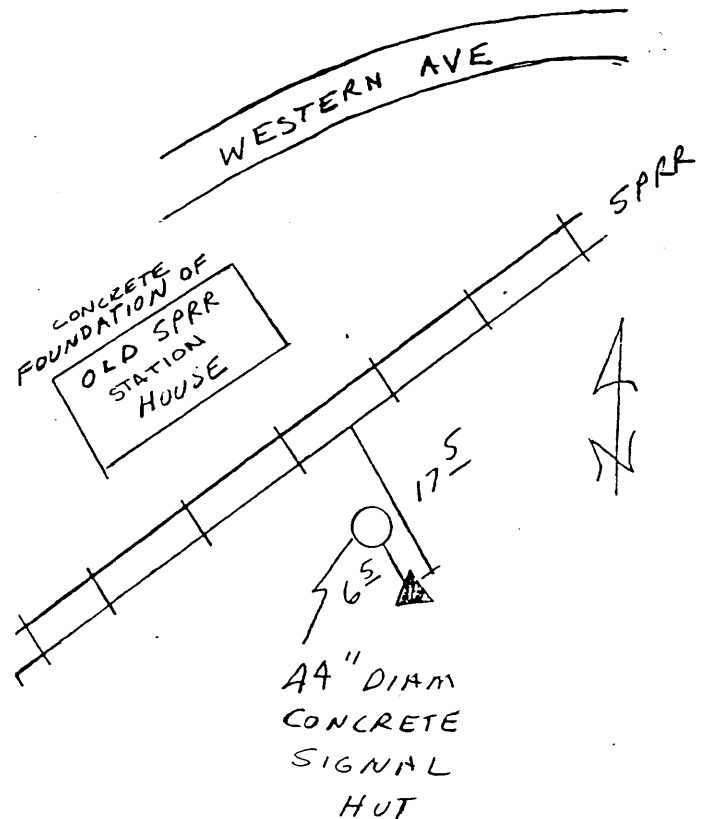

Note: For further information contact the Douglas County Surveyors Office, Room 105A Douglas County Courthouse, Roseburg, OR 97470. Phone 440-4272 or Fax (541)957-8150. Douglas County Residents outside Roseburg calling area, dial toll free 1-800-224-1619.