


0-029

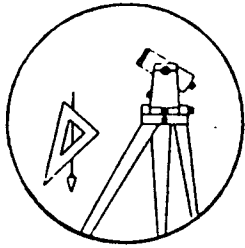

Station: OLA-8

T 29 S, R 7W, Sec 5


Date Set: 1999

Set By (Agency): DCSO

Date Recovered: JAN 13 1998

Recovered By: RWS, SOF

- Found
- New
- Reset
- Not Found
- Referenced
- Destroyed

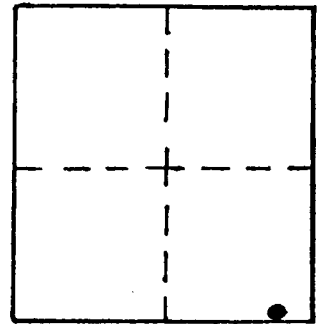

VERTICAL CONTROL CORPSCON6 NAVD88 746.36 FT.

0-029

Elevation: 742.94 NGS Line # _____ USGS Line # _____ OSHD Line # _____

Precision: 3rd Agency: DCSO Proj. # 2007 Date: 1999

HORIZONTAL CONTROL

CS 66/50

South Zone O.C.S. 27: Y(Northing) _____ X(Easting) _____

South Zone O.C.S. 83: Y(Northing) 526991 X(Easting) 4108157

Precision: GIS SCALED Agency: DCSO Proj. # _____ Date: 2014

Approx. NAD ⁸³ Geographic Position: Latitude 43° 04' 20" Longitude 123° 32' 33"


DESCRIPTION and TO REACH

2°

A 3 INCH DIAMETER DCSO DISK STAMPED "OLA-8 1999"
SET FLUSH IN TOP OF 8 INCH DIAMETER, CONCRETE FILLED, 40 INCH
LONG PVC PIPE SEGMENT, FIRMLY SET AND PROTRUDING
APPROXIMATELY 9 INCHES ABOVE GROUND.

FROM THE INTERSECTION HOOVER HILL ROAD (CO. RD. #125)
AND OLALLA ROAD (CO. RD. #38) IN T28S, R7W, SEC 34
PROCEED SOUTHWESTERLY ALONG OLALLA ROAD APPROXIMATELY
2° MILES TO MONUMENT ON RIGHT.

Reference Marks:

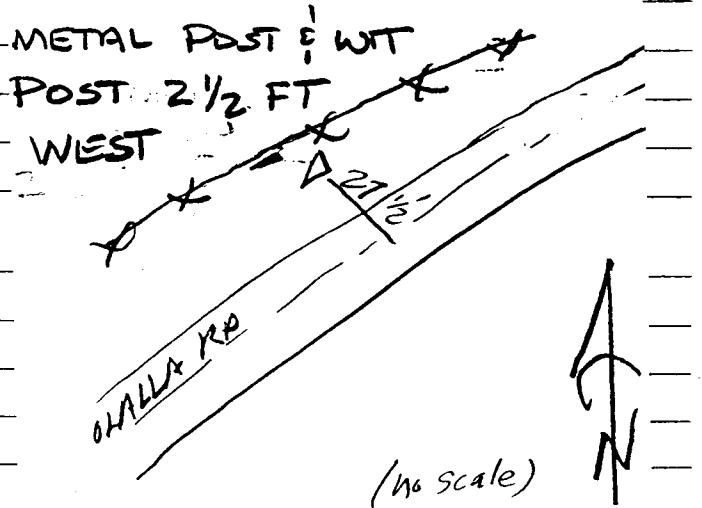

N?