



OFFICE OF THE
DOUGLAS COUNTY SURVEYOR

0-030

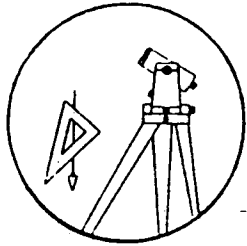

Station: OLA-9
Date Set: 1998
Set By (Agency): DCSO
Date Recovered: 11-23-98
Recovered By: RWS, SJF

T 29 S, R 7W, Sec 8

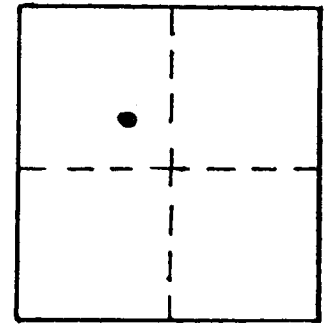

- Found New
 Reset Not Found
 Referenced Destroyed

VERTICAL CONTROL CORPSCON6 NAVD88 806.14 FT.
Elevation: 802.72 NGS Line # _____ USGS Line # _____ OSHD Line # _____
Precision: 3rd Agency: DCSO Proj. # 2007 Date: 1999

HORIZONTAL CONTROL CS 66/50
South Zone O.C.S. 27: Y(Northing) _____ X(Easting) _____
South Zone O.C.S. 83: Y(Northing) 525203 X(Easting) 4105196
Precision: GIS SCALED Agency: DCSO Proj. # _____ Date: 2014
Approx. NAD 83 Geographic Position: Latitude 43°04'02" Longitude 123°33'12"

DESCRIPTION and TO REACH

GO TO THE INTERSECTION OF OLALLA ROAD
(CORP #35) AND IRELAND RD (CO RD #170)
IN T29S R7W S8E8, PROCEED SOUTHWEST
ALONG OLALLA ROAD APPROX 190' TO MONUMENT
ON LEFT

DCSO BRASS CAP IS SET IN SOUTH WEST
CORNER OF A 4'X4' CONCRETE PAD STAMPED
"OLA-9-1998"

Reference Marks:

