


0-034

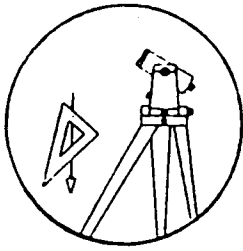

Station: OLA-13

T 29 S, R 7W, Sec 21


Date Set: 1998

Set By (Agency): DCSO

Date Recovered: 12-17-98

Recovered By: RWS SIF

- Found
- Reset
- Referenced
- New
- Not Found
- Destroyed

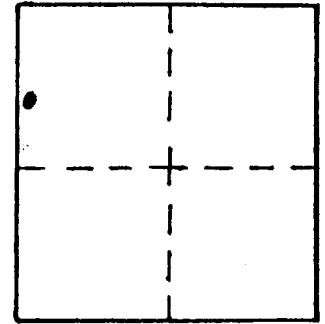

0-034

VERTICAL CONTROL CORPSCON6 NAVD88 772.48 FT.

Elevation: 769.05 NGS Line # _____ USGS Line # _____ OSHD Line # _____

Precision: 3rd Agency: DCSO Proj. # 2007 Date: 1998

HORIZONTAL CONTROL

CS 66150

South Zone O.C.S. 27: Y(Northing) _____ X(Easting) _____

South Zone O.C.S. 83: Y(Northing) 514889 X(Easting) 4107710

Precision: GIS SCALED Agency: DCSO Proj. # _____ Date: 2014

Approx. NAD ⁸³ Geographic Position: Latitude 43° 02' 20" Longitude 123° 32' 33"

DESCRIPTION and TO REACH

DCSO BRASS CAP SET IN TOP OF A 2 FT BY 2 FT
ROCK OUTCROP, STAMPED "OLA-13 1998"

FROM THE INTERSECTION OF OLALLA RD (CO. RD #38)
AND IRELAND RD (CO. RD #140) IN T29S R7W SEC. 8
PROCEED SOUTHERLY ALONG OLALLA ROAD 2.25 MILES
TO MONUMENT ON LEFT.

Reference Marks:

