


0-036

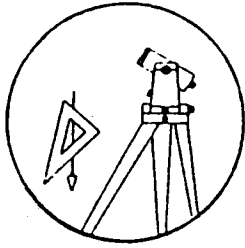

Station: OLA-15

T 29 S, R 7W, Sec 29


Date Set: 1999

Set By (Agency): DCSO

Date Recovered: 01/13/99

Recovered By: RWS, SJF

- Found
- New
- Reset
- Not Found
- Referenced
- Destroyed

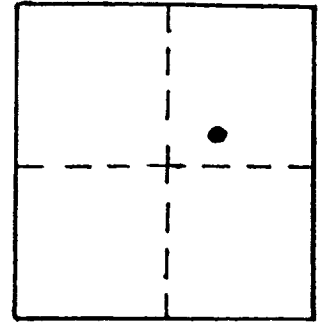

0-036

VERTICAL CONTROL CORPSCON6 NAVD88 816.61 FT.

Elevation: 913.18 NGS Line # _____ USGS Line # _____ OSHD Line # _____

Precision: 3rd Agency: DCSO Proj. # 2007 Date: 1999

HORIZONTAL CONTROL

South Zone O.C.S. 27: Y(Northing) _____ X(Easting) _____

South Zone O.C.S. 83: Y(Northing) 509500 X(Easting) 4106251

Precision: GIS SCALED Agency: DCSO Proj. # _____ Date: 2014

Approx. NAD 83 Geographic Position: Latitude 43° 01' 27 Longitude 123° 32' 50

DESCRIPTION and TO REACH

A 3 INCH DIAMETER DCSO DISK STAMPED "OLA-15 1999)
SET FLUSH IN TOP OF 8 X 42 INCH, CONCRETE FILLED, CONCRETE
BELL-TILE; FIRMLY SET AND PROTRUDING APPROXIMATELY
3 INCHES ABOVE GROUND.

FROM THE INTERECTION OF IRELAND ROAD (Co. RD. #140)
AND OLALLA ROAD (Co. RD. #38) IN T29S, R7W, SEC 8
PROCEED SOUTHERLY ALONG OLALLA RD. APPROXIMATELY
3.50 MILES TO MONUMENT ON RIGHT.

Reference Marks:

wp x 2' 0' 12

