



OFFICE OF THE  
DOUGLAS COUNTY SURVEYOR

P-019

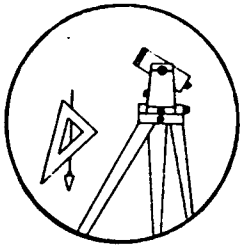

Station: P 615 T 31 S, R 5 W, Sec 2  
Set By (Agency): OSHD  
Date Set: 1966  
Recovered By RWS, SIF  
Date Recovered 1/28/85  
Recovered By \_\_\_\_\_  
Date Recovered \_\_\_\_\_  
Recovered By \_\_\_\_\_  
Date Recovered \_\_\_\_\_

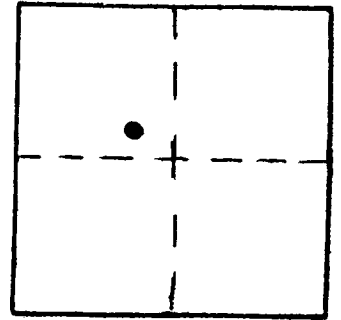

VERTICAL CONTROL CORPSCONG NAVDBB 869.27 FT.

Elevation: 865.88 NGS Line # \_\_\_\_\_ USGS Line # \_\_\_\_\_ OSHD Line # 369  
Precision: 3rd Agency: OSHD Proj. # \_\_\_\_\_ Date: 1980

HORIZONTAL CONTROL

South Zone State Plane Coordinates: Y(Northing) 469173 X(Easting) 4182429  
Precision: GIS SCALED Agency: DCSO Proj. # \_\_\_\_\_ Date: 2014  
Approximate Geographic Position: Latitude \_\_\_\_\_ Longitude \_\_\_\_\_

DESCRIPTION and TO REACH


SKETCH

DESCRIPTION:

An OSHD disk stamped "P 615 1968"  
set flush in concrete culvert headwall  
lo. 6792A

TO REACH:

From the Richie Rd. overcrossing of I-5 (exit 95)  
in T31S,R5W,Sec.2, proceed northwesterly  
along I-5, 0.8 miles to monument on right.

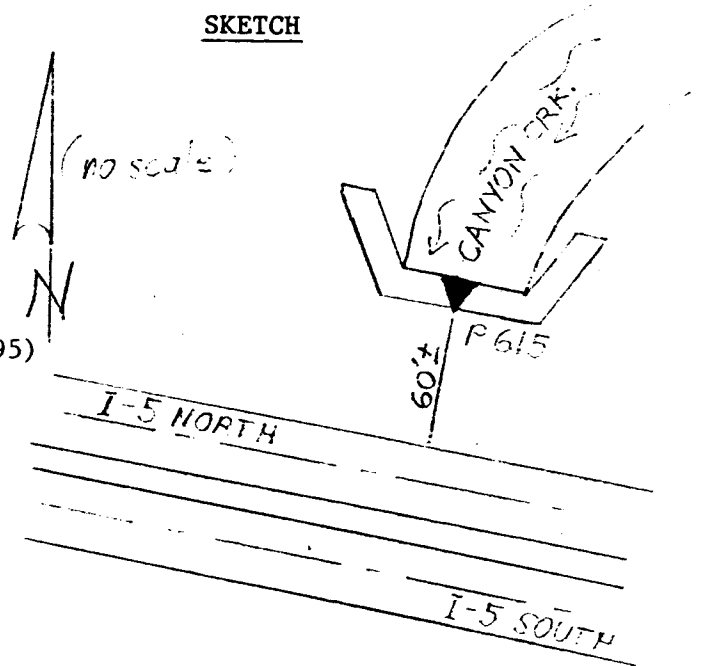

Reference Marks:

Note: For further information, contact the Douglas County Surveyor's Office, Room 205  
Douglas County Justice Building, Roseburg, OR 97470. Phone 440-4278. Douglas  
County residents outside the Roseburg calling area, dial toll free 1-800-452-0991.