


OFFICE OF THE
DOUGLAS COUNTY SURVEYOR

Station: PETE
 Set By (Agency): DCSO
 Date Set: 1974
 Recovered By FLI (DCSO)
 Date Recovered 8-1-84
 Recovered By _____
 Date Recovered _____
 Recovered By _____
 Date Recovered _____

UNS
T 28 S, R 5 E, Sec 8

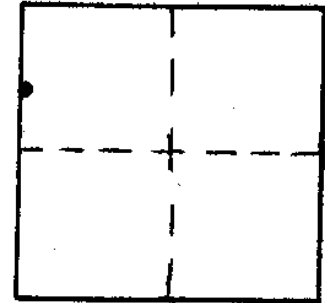

p-031
PETE

285 SE 8

NAD 574058.34 4163196.25
 83 43°12'23" 123°20'38"

VERTICAL CONTROL **NGVD 29**

Elevation: 5676.932 NGS Line # _____ USGS Line # _____ OSHD Line # _____
 Precision: 2nd Agency: DCSO Proj. # 2004-8 CS57/23 Date: 1974

HORIZONTAL CONTROL **OCS 27**


South Zone State Plane Coordinates: Y(Northing) 546,300.13 X(Easting) 1,529,841.16
 Precision: 1/25,000 Agency: DCSO Proj. # 2004-8 CS57/23 Date: 1975
 Approximate Geographic Position: Latitude 43°09'07" Longitude 122°15'43"

DESCRIPTION and TO REACH

SKETCH

From the intersection of Highway 230 and USFS Road No. 3703 (Formerly 284), go NW along Road No. 3703 4.6 miles to junction of Road No. 3603 and Road No. 450. (Signs indicate Road 450 is 2735 and 4785, map says 450.) Go right on Road 450 1.2 miles to station on left.

Brass cap in 6" belltile, 280 ft. west of the centerline of Road 450, across creek on small ridge.

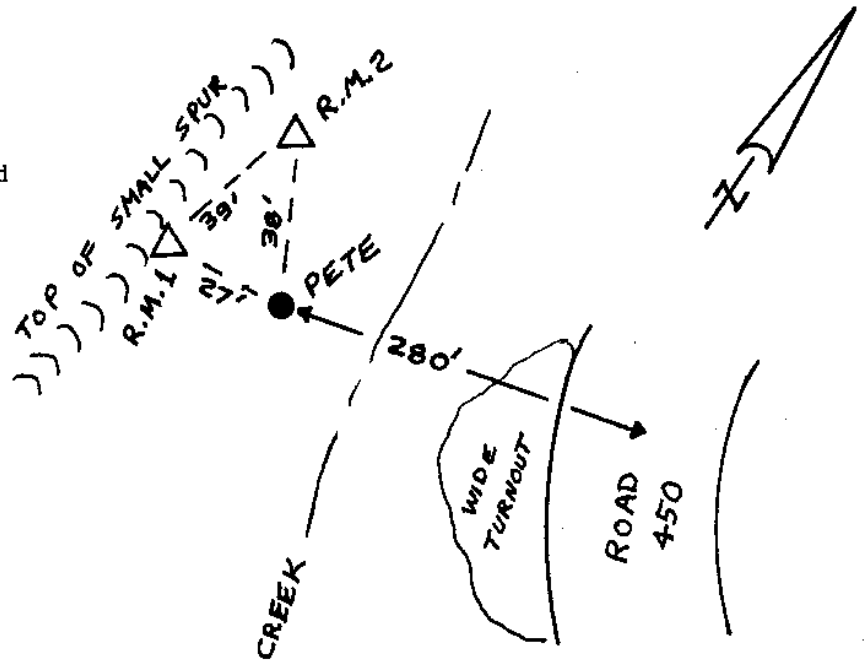

Reference Marks:	PETE R.M. 1	Brass cap in 6" belltile (El. 5684.475)
		546,295.11 1,529,814.54
	PETE R.M. 2	Brass cap in 6" belltile (El. 5677.387)
		546,333.44 1,529,822.43

Note: For further information, contact the Douglas County Surveyor's Office, Room 205 Douglas County Justice Building, Roseburg, OR 97470. Phone 440-4278. Douglas County residents outside the Roseburg calling area, dial toll free 1-800-452-0991.