


OFFICE OF THE
DOUGLAS COUNTY SURVEYOR


Station: POT 35 LF TO SHRP
 Set By (Agency): POT 410+00 OSHD
 Date Set: ?
 Recovered By JP,RS,JRL
 Date Recovered 8/15/83
 Recovered By _____
 Date Recovered _____
 Recovered By _____
 Date Recovered _____

T 32 S, R 6 W, Sec 36

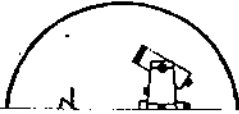

p-048 32S 6W 36
P.O.T. 35 LF

NAD 408807.57 4153482.36
83 42°45' 9" 123°21'33"

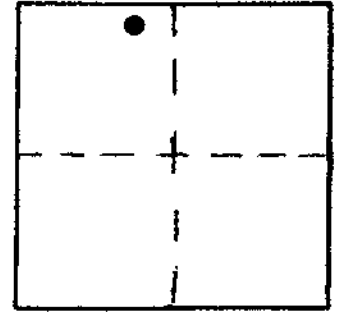

VERTICAL CONTROL

Elevation: _____ NGS Line # _____ USGS Line # _____ OSHD Line # _____
 Precision: _____ Agency: _____ Proj. # _____ Date: _____

HORIZONTAL CONTROL

South Zone State Plane Coordinates: Y(Northing) 408,843.67 X(Easting) 1,232,523.75
 Precision: 1/25,000 Agency: DCSO Proj. # 2006 Date: 1973
 Approximate Geographic Position: Latitude 42°45'09" Longitude 123°21'29"

DESCRIPTION and TO REACH


DESCRIPTION:

A OSHD disk stamped "POT 35.00 POT 410+00"
set in a 6 in. by 6 in. concrete post.

TO REACH:

From the Glendale I-5 interchange (exit 80)
in T32S,R6W,Sec.35; proceed northerly
along I-5 0.75 miles to monument on
right.

SKETCH

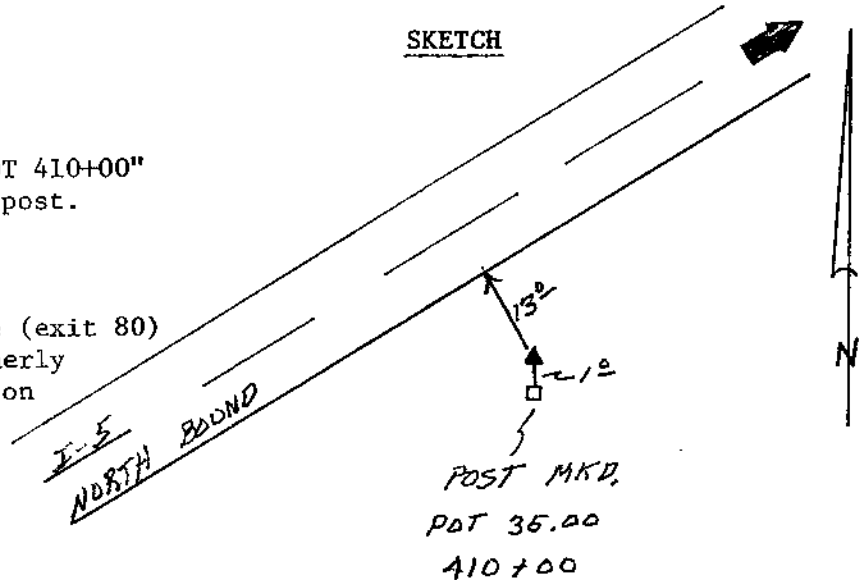

POST MKD.
POT 35.00
410+00

Reference Marks:

Note: For further information, contact the Douglas County Surveyor's Office, Room 205 Douglas County Justice Building, Roseburg, OR 97470. Phone 440-4278. Douglas County residents outside the Roseburg calling area, dial toll free 1-800-452-0991.