

OFFICE OF THE
DOUGLAS COUNTY SURVEYOR

Station: PT 320+72.80 T 31 S, R 5 W , Sec 24

Set By (Agency): OSHD

Date Set: ?

Recovered By RS,JP



Date Recovered 9/15/83

Recovered By _____

Date Recovered _____

Recovered By _____

Date Recovered _____

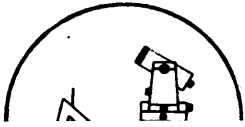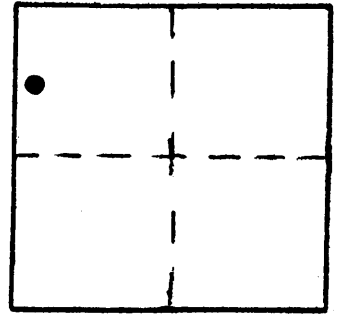

p-051 31S 5W 24
P.T. 320 + 72.80

NAD 449222.26 4185080.99
83 42°51'58" 123°14'48"

VERTICAL CONTROL

Elevation: _____ NGS Line # _____ USGS Line # _____ OSHD Line # _____

Precision: _____ Agency: _____ Proj. # _____ Date: _____

HORIZONTAL CONTROL *OCS 27*

South Zone State Plane Coordinates: Y(Northing) 449,258.33 X(Easting) 1,264,122.30

Precision: 1/25,000 Agency: DCSO Proj. # 2008 Date: 1975

Approximate Geographic Position: Latitude 42°51'59" Longitude 123°14'44"

DESCRIPTION and TO REACH


SKETCH

DESCRIPTION:

Station is a aluminum cap on a iron rod set flush in a 1 ft. diam. concrete post stamped "OSHD".

TO REACH:

From intersection of I-5 and Co. Rd. #36 (Upper Cow Creek Rd. exit #88) in T32S,R5W, Sec.11, proceed northerly along I-5 5.0 miles to monument on left.

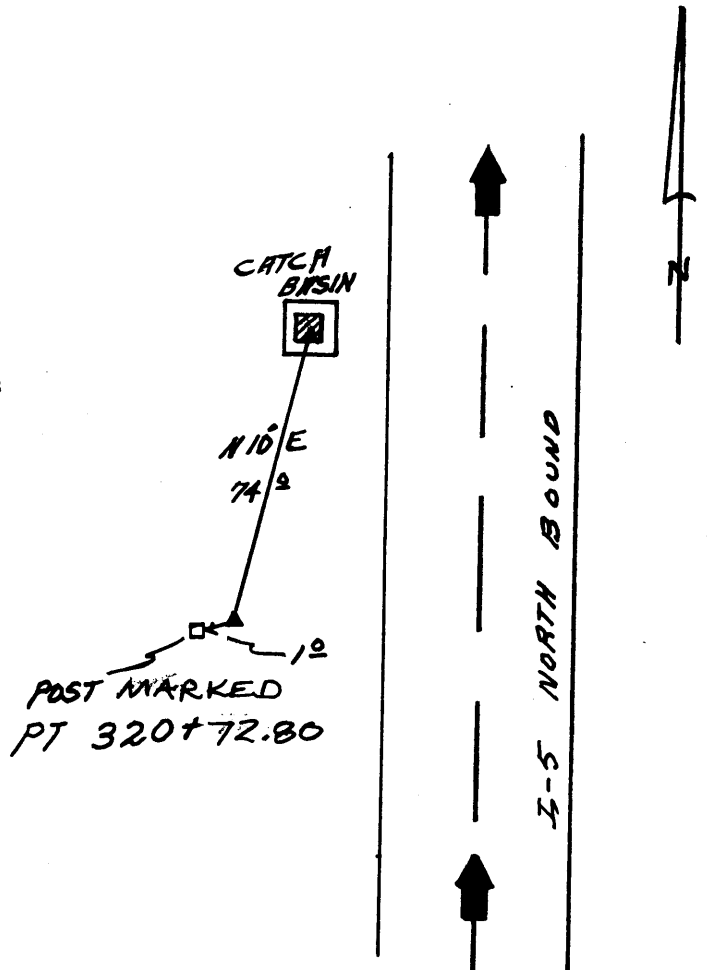

Reference Marks:

Note: For further information, contact the Douglas County Surveyor's Office, Room 205 Douglas County Justice Building, Roseburg, OR 97470. Phone 440-4278. Douglas County residents outside the Roseburg calling area, dial toll free 1-800-452-0991.