

OFFICE OF THE  
DOUGLAS COUNTY SURVEYOR

Station: PT 491+53.52 T 32 S, R 5 W , Sec 2

Set By (Agency): OSHD

Date Set: ?

Recovered By RS,JP


Date Recovered 9/15/83

Recovered By \_\_\_\_\_

Date Recovered \_\_\_\_\_

Recovered By \_\_\_\_\_

Date Recovered \_\_\_\_\_

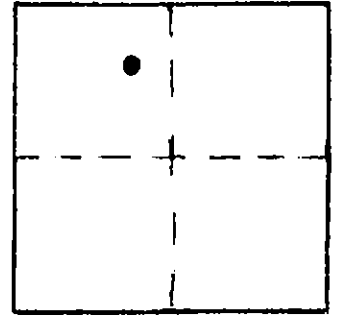

p-002 325 54 2  
PT 491 + 53.52

RAD 434043.30 4130811.02  
23 42°49'27" 123°15'34"

VERTICAL CONTROL

Elevation: \_\_\_\_\_ NGS Line # \_\_\_\_\_ USGS Line # \_\_\_\_\_ OSHD Line # \_\_\_\_\_

Precision: \_\_\_\_\_ Agency: \_\_\_\_\_ Proj. # \_\_\_\_\_ Date: \_\_\_\_\_

HORIZONTAL CONTROL

South Zone State Plane Coordinates: Y(Northing) 434,043.30 X(Easting) 1,259,853.02

Precision: 1/25,000 Agency: DCSO Proj. # 2008 Date: 1975

Approximate Geographic Position: Latitude 42°49'27" Longitude 123°15'34"

DESCRIPTION and TO REACH


SKETCH

DESCRIPTION:

A OSHD disk stamped "25 PT491+53.52" set in a 6 in. square concrete post flush with ground.

TO REACH:

From the intersection of I-5 and Co. Rd. #36 (Upper Cow Creek Rd. exit #88) in T32S,R5W,Sec.11, proceed northerly along I-5 1.8 miles to monument on left.

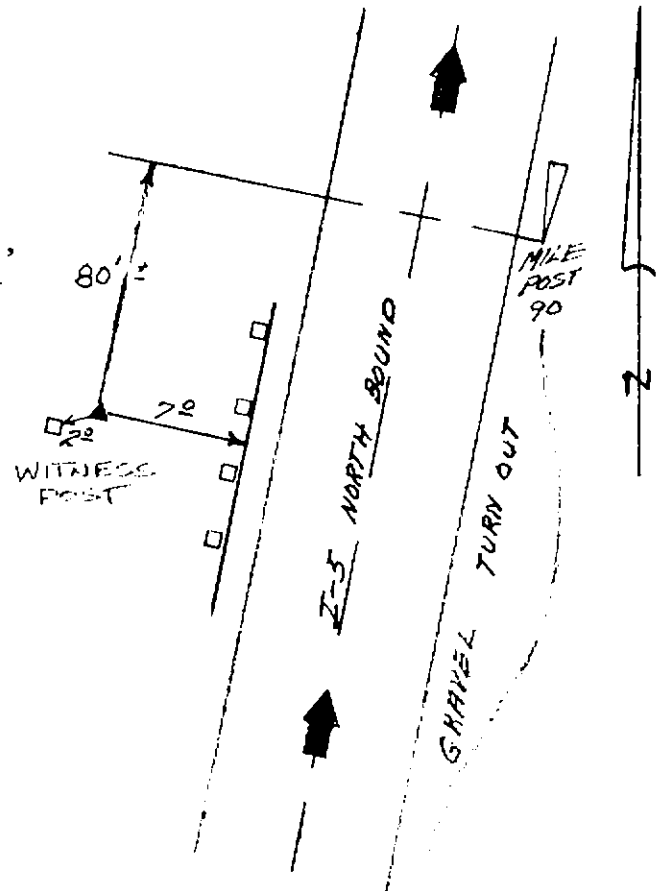

Reference Marks:

Note: For further information, contact the Douglas County Surveyor's Office, Room 205 Douglas County Justice Building, Roseburg, OR 97470. Phone 440-4278. Douglas County residents outside the Roseburg calling area, dial toll free 1-800-452-0991.