

OFFICE OF THE
DOUGLAS COUNTY SURVEYOR

Station: PTS-8. T 32 S, R 5W , Sec 22

Set By (Agency): 1973

Date Set: DCSO

Recovered By JP RWS


Date Recovered 2-9-82

Recovered By O.D.O.T. 10/10/01

Date Recovered _____

Recovered By _____

Date Recovered _____

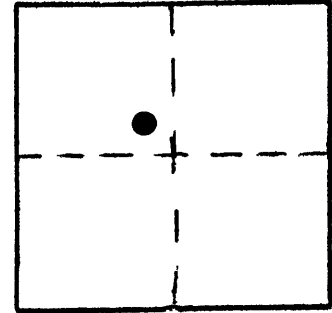

p-061
PTS-8

32S 5W 22

NAD 417472.12 4175214.36
83 42°46'42" 123°16'46"

VERTICAL CONTROL NGVD 29

Elevation: 1,582.960 NGS Line # _____ USGS Line # _____ OSHD Line # _____

Precision: 2nd Agency: DCSO Proj. # 2006 Date: 1973

HORIZONTAL CONTROL OCS 27

South Zone State Plane Coordinates: Y(Northing) 417,508.35 X(Easting) 1,254,255.68

Precision: 1/25,000 Agency: DCSO Proj. # 2006 Date: 1973


Approximate Geographic Position: Latitude 42°46'42" Longitude 123°16'42"

DESCRIPTION and TO REACH

SKETCH

Found: A standard DCSO disk marked "PTS-8 1973" Station is set flush on curb of overpass 0.7-ft. above the road surface.

To reach: Station mark is at Exit #86 (Quines Creek) of I-5 in T32S R5W sec. 22 at the Southerly end on the Westerly side of the overpass.

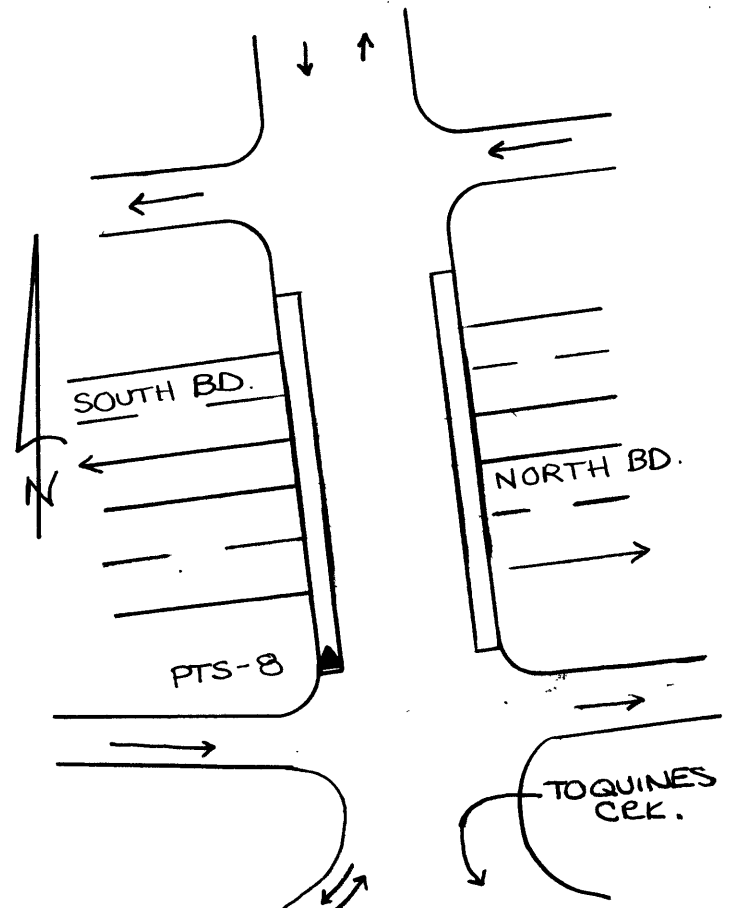

Reference Marks:

Note: For further information, contact the Douglas County Surveyor's Office, Room 205 Douglas County Justice Building, Roseburg, OR 97470. Phone 440-4278. Douglas County residents outside the Roseburg calling area, dial toll free 1-800-452-0991.