
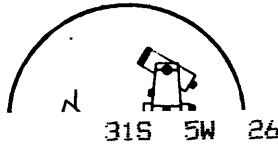


OFFICE OF THE
DOUGLAS COUNTY SURVEYOR

Station: PTS-14 T 31 S, R 5 W, Sec 26
 Set By (Agency): DCSO
 Date Set: 1975
 Recovered By JMP-RS
 Date Recovered 1/82
 Recovered By _____
 Date Recovered _____
 Recovered By _____
 Date Recovered _____

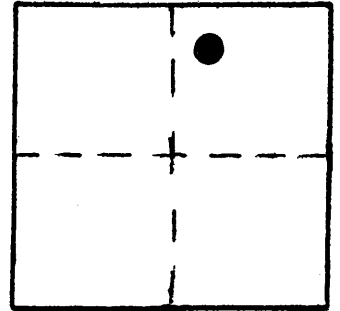

p-067
PTS-14

NAD 443791.11 4182886.03
83 42°51' 4" 123°15' 15"

VERTICAL CONTROL

Elevation: _____ NGS Line # _____ USGS Line # _____ OSHD Line # _____
 Precision: _____ Agency: _____ Proj. # _____ Date: _____

HORIZONTAL CONTROL **OCS 27**


South Zone State Plane Coordinates: Y(Northing) 443,827.21 X(Easting) 1,261,927.34
 Precision: 1/25,000 Agency: DCSO Proj. # 2008 Date: 1975
 Approximate Geographic Position: Latitude 42°51'04" Longitude 123°15'11"

DESCRIPTION and TO REACH

Station is a standard DCSO disk set in a drain basin and stamped "PTS-14 1975".

To Reach: From the intersection of Co. Rd. 36 (Cow Cr. Rd.) and I-5 (Exit No. 88 at Azalea) in S.2 T31S, R5W, proceed northerly along I-5 4.05 mi. to monument on right. Approx. 100 ft. northerly from milepost 92.

SKETCH

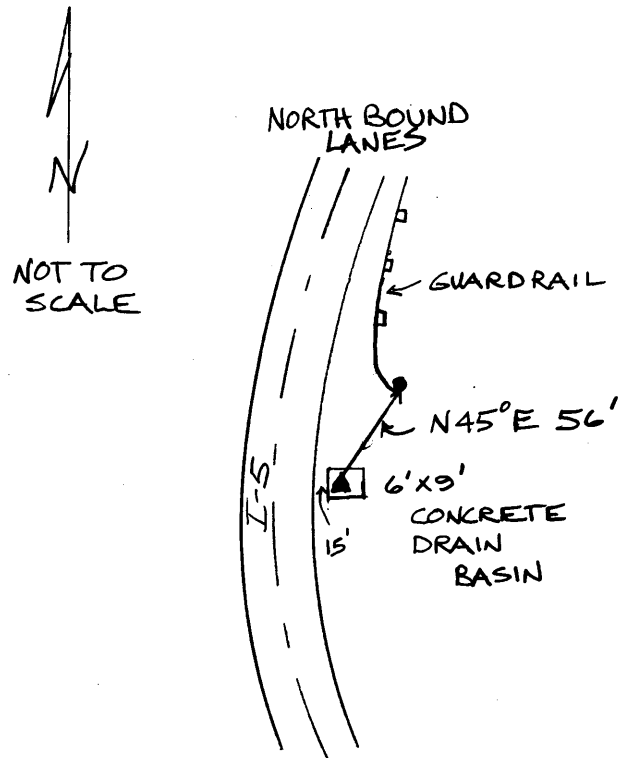

Reference Marks:

Note: For further information, contact the Douglas County Surveyor's Office, Room 205 Douglas County Justice Building, Roseburg, OR 97470. Phone 440-4278. Douglas County residents outside the Roseburg calling area, dial toll free 1-800-452-0991.