


OFFICE OF THE
DOUGLAS COUNTY SURVEYOR

Station: PTS-101-3
 Set By (Agency): DCSO
 Date Set: 1975
 Recovered By GQ - TP
 Date Recovered 2-3-82
 Recovered By _____
 Date Recovered _____
 Recovered By _____
 Date Recovered _____

T 22 S, R 12W , Sec 30

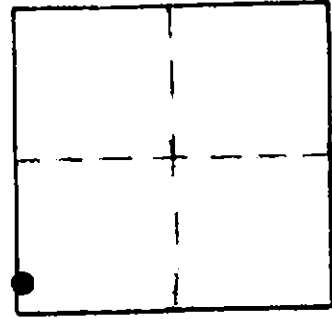

p-056
PTS 101-3

225 12W 30

NAD 736776.56 2746555.56
 82 43°37'46" 124°11'0"

VERTICAL CONTROL

Elevation: _____ NGS Line # _____ USGS Line # _____ OSHD Line # _____
 Precision: _____ Agency: _____ Proj. # _____ Date: _____

HORIZONTAL CONTROL


South Zone State Plane Coordinates: Y(Northing) 736,811.58 X(Easting) 1,025,394.93
 Precision: 1/15,000 Agency: DCSO Proj. # 6004-16 Date: 1975
 Approximate Geographic Position: Latitude 43°37'47" Longitude 124°10'56"

DESCRIPTION and TO REACH

SKETCH

Found: A standard DCSO disk set in concrete tile stamped "PTS 101-3 1975".

To reach: From the junction of Hwy. 101 & William M. Tugman State Park entrance (in sec 6 T23S R12W) Proceed northerly along Hwy. 101 2.1 mi. to monument on the right.

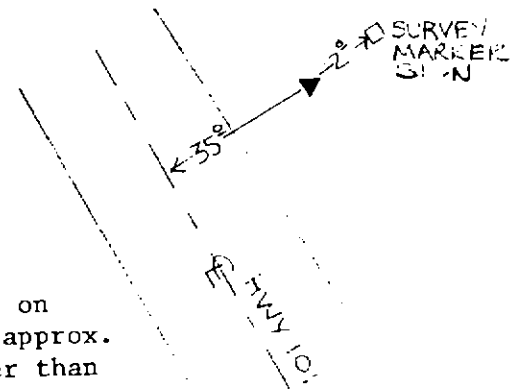

Monument is on sandy bank approx. 3 ft. higher than road.

Reference Marks:

Note: For further information, contact the Douglas County Surveyor's Office, Room 205 Douglas County Justice Building, Roseburg, OR 97470. Phone 440-4278. Douglas County residents outside the Roseburg calling area, dial toll free 1-800-452-0991.