

OFFICE OF THE  
DOUGLAS COUNTY SURVEYOR

Station: PTS 101-9 T 22 S, R 13W, Sec 13

Set By (Agency): DCSO

Date Set: 1975

Recovered By GQ - TP



Date Recovered 2-3-82

Recovered By \_\_\_\_\_

Date Recovered \_\_\_\_\_

Recovered By \_\_\_\_\_

Date Recovered \_\_\_\_\_

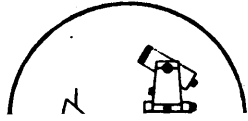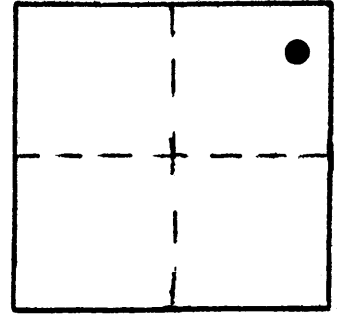

p-089  
PTS 101-9

225 13W 13

NAD 749766.52 3946131.01  
83 43°39'54" 124°11'11"

VERTICAL CONTROL

Elevation: \_\_\_\_\_ NGS Line # \_\_\_\_\_ USGS Line # \_\_\_\_\_ OSHD Line # \_\_\_\_\_

Precision: \_\_\_\_\_ Agency: \_\_\_\_\_ Proj. # \_\_\_\_\_ Date: \_\_\_\_\_

HORIZONTAL CONTROL **NAD 27**

South Zone State Plane Coordinates: Y(Northing) 749,801.52 X(Easting) 1,025,170.34

Precision: 1/15,000 Agency: DCSO Proj. # 6004-16 Date: 1975



Approximate Geographic Position: Latitude 43°39'55" Longitude 124°11'07"

DESCRIPTION and TO REACH

SKETCH

Found: Standard DCSO disk set in concrete tile stamped "PTS-101-9 1975".

To reach: From the junction of Salmon Harbor Rd. #251 & Hwy. 101 (in sec 7 T22S R12W) proceed southerly along Hwy. 101 0.9 mi. to Rd. to beach and monument on the right.

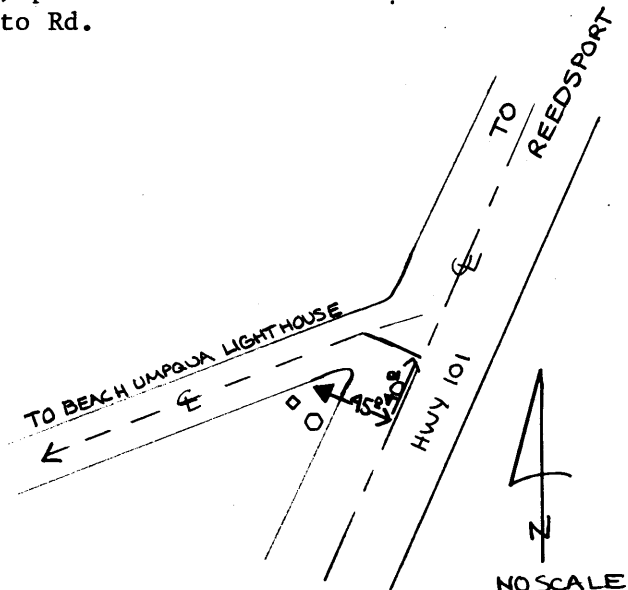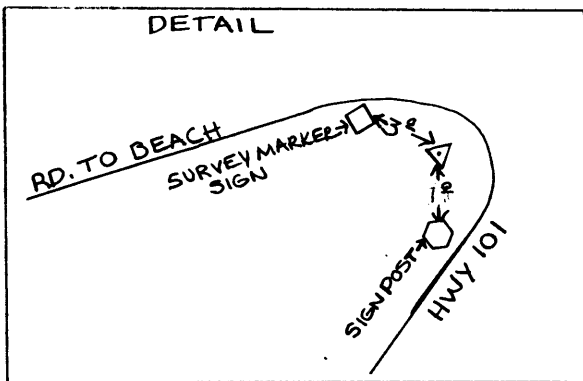

Note: For further information, contact the Douglas County Surveyor's Office, Room 205 Douglas County Justice Building, Roseburg, OR 97470. Phone 440-4278. Douglas County residents outside the Roseburg calling area, dial toll free 1-800-452-0991.