

write/rain P-113 POS GPS

OFFICE OF THE DOUGLAS COUNTY SURVEYOR

Station: POM


T 23 S, R 4W, Sec 10

Date Set: 1997


Set By (Agency): DCSG

Date Recovered: 2-19-97

Recovered By: RWS, STF

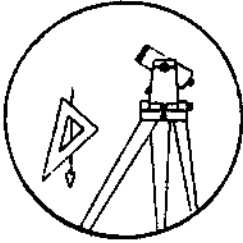

- Found
- New
- Reset
- Not Found
- Referenced
- Destroyed

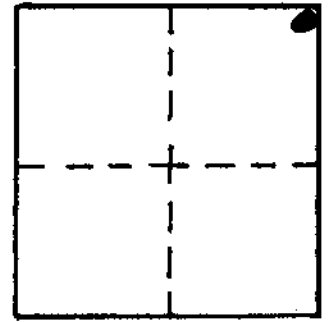

VERTICAL CONTROL NGVD 29

Elevation: 884.80 NGS Line # \_\_\_\_\_ USGS Line # \_\_\_\_\_ OSHD Line # \_\_\_\_\_

Precision: 3rd Agency: DCSG Proj. # 2007 Date: 1997

HORIZONTAL CONTROL

South Zone O.C.S. 27: Y(Northing) \_\_\_\_\_ X(Easting) \_\_\_\_\_

South Zone O.C.S. 83: Y(Northing) \_\_\_\_\_ X(Easting) \_\_\_\_\_

Precision: \_\_\_\_\_ Agency: \_\_\_\_\_ Proj. # \_\_\_\_\_ Date: \_\_\_\_\_

Approx. ~~NAD 83~~ Geographic Position: Latitude 43°35'29" Longitude 123°08'47"

DESCRIPTION and TO REACH

8" DIA. BY 42" LONG CONCRETE FILLED BELLTILE WITH A DCSG BRASS CAP STAMPED "POM 1997" PROTRUSING 3" ABOVE GROUND

FROM THE INTERSECTION OF SCOTTS VALLEY RD (CO. RD #29) AND LONDON RD (CO. RD #8A) IN T23S R4W SEC 3, PROCEED SOUTHERLY ALONG SCOTTS VALLEY ROAD 0.9 MILES TO BARN AND MOVEMENT OF LEFT.

Reference Marks:

