

OFFICE OF THE  
DOUGLAS COUNTY SURVEYOR

Station: PAGE-1

T 26 S, R 5W, Sec 30


Date Set: 2000

Set By (Agency): DCSO

Date Recovered: 3-23-00

Recovered By: RWS SJF

- |                                     |   |
|-------------------------------------|---|
| <input type="checkbox"/> Found      | <input checked="" type="checkbox"/> New |
| <input type="checkbox"/> Reset      | <input type="checkbox"/> Not Found      |
| <input type="checkbox"/> Referenced | <input type="checkbox"/> Destroyed      |

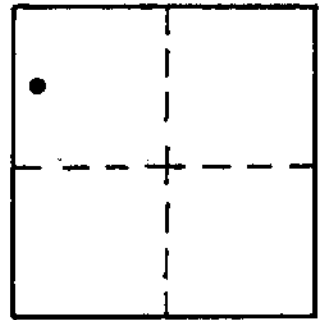

P-118

VERTICAL CONTROL NGVD 29

Elevation: 511.08 NGS Line # \_\_\_\_\_ USGS Line # \_\_\_\_\_ OSHD Line # \_\_\_\_\_

Precision: 3rd Agency: DCSO Proj. # 2007 Date: 2000

HORIZONTAL CONTROL

South Zone O.C.S. 27: Y(Northing) \_\_\_\_\_ X(Easting) \_\_\_\_\_

South Zone O.C.S. 83: Y(Northing) \_\_\_\_\_ X(Easting) \_\_\_\_\_

Precision: \_\_\_\_\_ Agency: \_\_\_\_\_ Proj. # \_\_\_\_\_ Date: \_\_\_\_\_

Approx. NAD <sup>83</sup> Geographic Position: Latitude 43° 17' 00.3" Longitude 123° 20' 47.8"  
 (27) 43° 17' 00.9" 123° 20' 43.6"

DESCRIPTION and TO REACH

DCSO DRILL CAP SET IN CONCRETE CURB  
STAMPED "PAGE-1 2000"

GO TO THE INTERSECTION OF THORA CIRCLE RD  
(CO. RD # 335E) AND PAGE RD (CO. RD # 115A)  
IN T26S R5W SEC. 30. MONUMENT IS NORTH  
OF INTERSECTION

Reference Marks:

