

OFFICE OF THE
DOUGLAS COUNTY SURVEYOR

Station: PAGE - 2



T 26 S, R 5W, Sec 30

Date Set: 3-00

Set By (Agency): DCS 0

Date Recovered: 3-23-00

Recovered By: RWS SJF

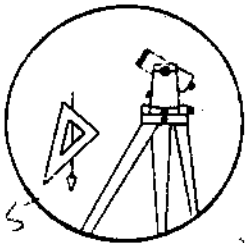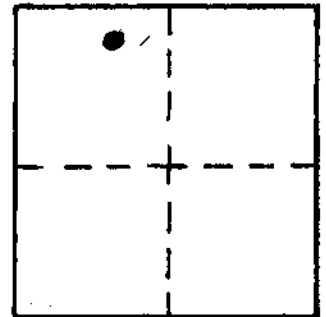

P-119

- Found
- New
- Reset
- Not Found
- Referenced
- Destroyed

VERTICAL CONTROL NGVD 29

Elevation: 474.03 NGS Line # _____ USGS Line # _____ OSHD Line # _____

Precision: 3rd Agency: DCSO Proj. # 2007 Date: 2000

HORIZONTAL CONTROL

South Zone O.C.S. 27: Y(Northing) _____ X(Easting) _____

South Zone O.C.S. 83: Y(Northing) _____ X(Easting) _____

Precision: _____ Agency: _____ Proj. # _____ Date: _____

Approx. NAD ⁸³ Geographic Position: Latitude 43° 17' 04.4" Longitude 123° 20' 26.1"
(27) 43° 17' 05.0" 123° 20' 21.8"

DESCRIPTION and TO REACH

DCSO DRILL CAP STAMPER "PAGE - 2 2000"
SET IN A CONCRETE DRAIN

GO TO THE INTERSECTION OF PAGE ROAD (CO. RD 115A)
AND WILD FERN DRIVE (CO. RD # 335F) IN T26S
RSW, SEC. 30 MONUMENT IS 80 FT SOUTH
OF INTERSECTION ON THE RIGHT.

Reference Marks:

