

OFFICE OF THE
DOUGLAS COUNTY SURVEYOR

Station: Q-9 T 29 S, R 6 W, Sec 12

Set By (Agency): USC&GS

Date Set: 1920

Recovered By PB,RS



Date Recovered 11/14/83

Recovered By _____

Date Recovered _____

Recovered By _____

Date Recovered _____

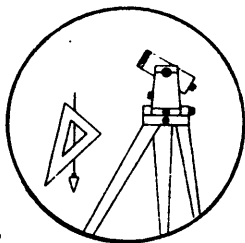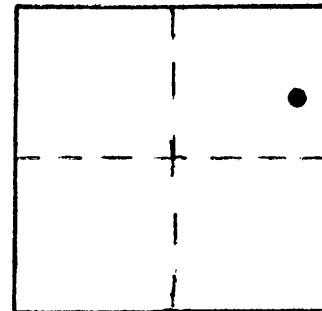

Q-001

VERTICAL CONTROL NGVD 29

Elevation: 578.152 NGS Line # 6 USGS Line # _____ OSHD Line # 369, 1977

Precision: 1st Agency: USC&GS Proj. # _____ Date: 1957

HORIZONTAL CONTROL

South Zone State Plane Coordinates: Y(Northing) _____ X(Easting) _____

Precision: _____ Agency: _____ Proj. # _____ Date: _____

Approximate Geographic Position: Latitude _____ Longitude _____

DESCRIPTION and TO REACH


SKETCH

DESCRIPTION:

A disk stamped "Q-9 1920 ELEV. 577.446 FT"
set flush in rock at the foot of a rock bluff.

TO REACH:

From the intersection of Dole Rd. (Co. Rd. #14)
and Clarks Branch Rd. (Co. Rd. #105) in T29S,
R6W, Sec.1, proceed southeasterly along Dole Rd.
1.10 miles to railroad crossing ROCK BLUFF
and monument on left.

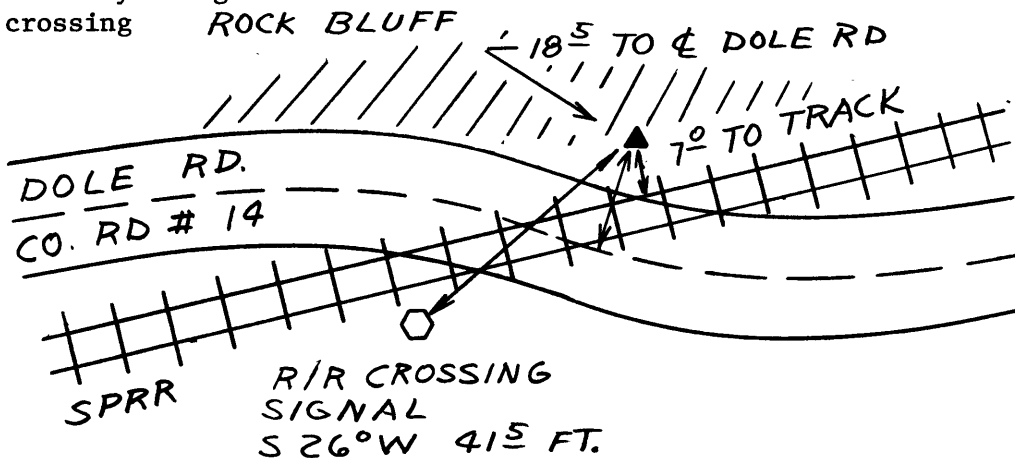

Reference Marks:

Note: For further information, contact the Douglas County Surveyor's Office, Room 205 Douglas County Justice Building, Roseburg, OR 97470. Phone 440-4278. Douglas County residents outside the Roseburg calling area, dial toll free 1-800-452-0991.