

OFFICE OF THE  
DOUGLAS COUNTY SURVEYOR

Station: Q-126 T 32 S, R 5 W, Sec 14

Set By (Agency): USC&GS

Date Set: 1943

Recovered By JP, RS



Date Recovered 8/17/83

Recovered By \_\_\_\_\_

Date Recovered \_\_\_\_\_

Recovered By \_\_\_\_\_

Date Recovered \_\_\_\_\_

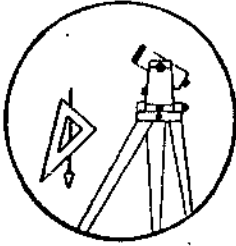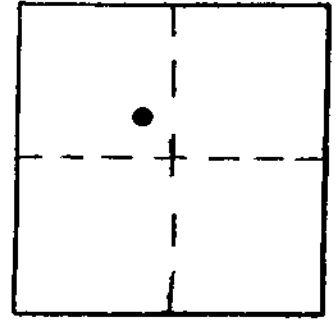

Q-004

VERTICAL CONTROL

Elevation: 1,643.839 NGS Line # \_\_\_\_\_ USGS Line # \_\_\_\_\_ OSHD Line # \_\_\_\_\_

Precision: 2nd Agency: DCSO Proj. # 2006 Date: 1975

HORIZONTAL CONTROL

South Zone State Plane Coordinates: Y(Northing) \_\_\_\_\_ X(Easting) \_\_\_\_\_

Precision: \_\_\_\_\_ Agency: \_\_\_\_\_ Proj. # \_\_\_\_\_ Date: \_\_\_\_\_

Approximate Geographic Position: Latitude \_\_\_\_\_ Longitude \_\_\_\_\_

DESCRIPTION and TO REACH


SKETCH

DESCRIPTION:

A USC&GS disk stamped "Q-126 1943"  
set flush in headwall.

TO REACH:

From Azalea post office proceed southwesterly  
along Fortune Branch Rd. (Co. Rd. #12) 0.1 miles  
to monument on right. All above in T32S, R5W, Sec.14.

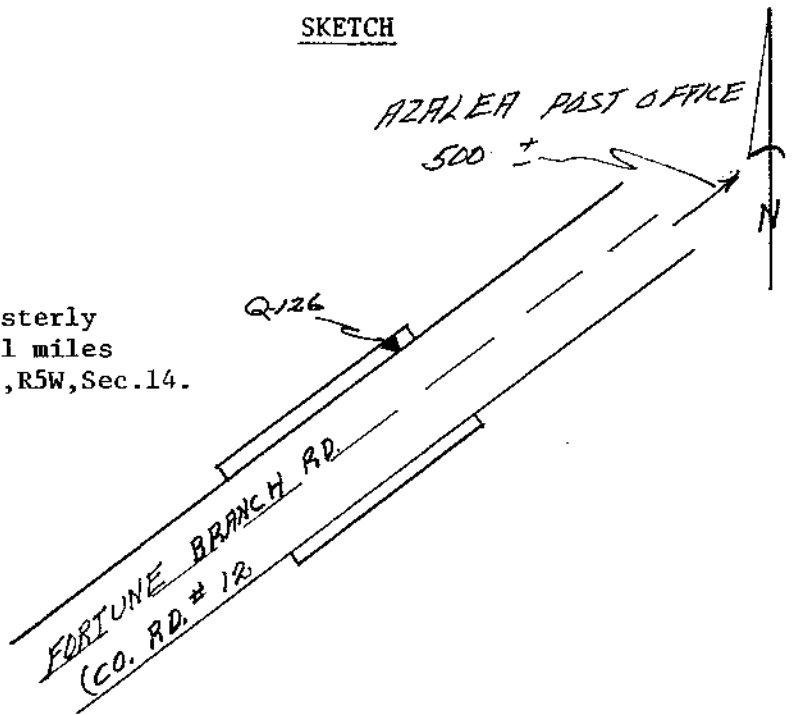

Reference Marks:

Note: For further information, contact the Douglas County Surveyor's Office, Room 205  
Douglas County Justice Building, Roseburg, OR 97470. Phone 440-4278. Douglas  
County residents outside the Roseburg calling area, dial toll free 1-800-452-0991.