



OFFICE OF THE
DOUGLAS COUNTY SURVEYOR

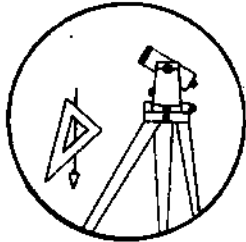

Q-011

Station: Q 476 T 26 S, R 2 W , Sec 14
 Set By (Agency): USC&GS
 Date Set: 1941
 Recovered By RWS, SJF
 Date Recovered 11/21/84
 Recovered By _____
 Date Recovered _____
 Recovered By _____
 Date Recovered _____

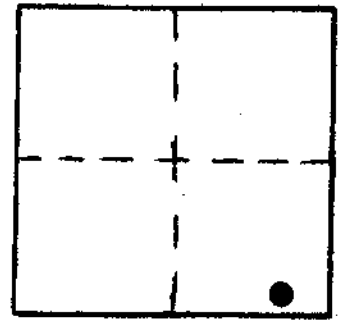

VERTICAL CONTROL NGND 29

Elevation: 934.207 NGS Line # 94 USGS Line # _____ OSHD Line # _____
 Precision: 1st. Agency: USC&GS Proj. # _____ Date: 1961

HORIZONTAL CONTROL

South Zone State Plane Coordinates: Y(Northing) _____ X(Easting) _____
 Precision: _____ Agency: _____ Proj. # _____ Date: _____
 Approximate Geographic Position: Latitude _____ Longitude _____


DESCRIPTION and TO REACH

A USC&GS disk stamped "Q 476 1941"
 set in a 8" square concrete post
 protruding 5" above ground.

TO REACH:

From the intersection of North Umpqua Hwy.
 (State Hwy #138) and Boundary Rd. (Co.Rd.#4B.6)
 in T26S,R2W,Sec.14, proceed easterly 0.3 miles
 along Boundary Rd. to monument on right.

SKETCH

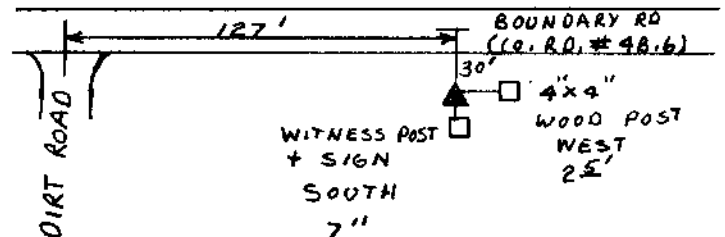

Reference Marks:

Note: For further information, contact the Douglas County Surveyor's Office, Room 205
 Douglas County Justice Building, Roseburg, OR 97470. Phone 440-4278. Douglas
 County residents outside the Roseburg calling area, dial toll free 1-800-452-0991.