

OFFICE OF THE  
DOUGLAS COUNTY SURVEYOR

Station: RPEQ T 27 S, R 5 W, Sec 18

Set By (Agency): OSHD

Date Set: ?

Recovered By GQ, KR, JP


Date Recovered 6/82

Recovered By DCSO 10/98

Date Recovered \_\_\_\_\_

Recovered By \_\_\_\_\_

Date Recovered \_\_\_\_\_

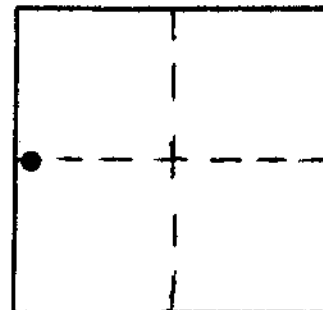

r-055  
RPEQ  
27S 5W 18

NAD 83 579518.30 4162960.37  
43°13'17" 123°20'44"

VERTICAL CONTROL

NGVD29

Elevation: 551.79 NGS Line # \_\_\_\_\_ USGS Line # \_\_\_\_\_ OSHD Line # \_\_\_\_\_

Precision: 3<sup>rd</sup> Agency: DCSO Proj. # 2007 Date: 10/98

CS66/46

HORIZONTAL CONTROL

NAD27

South Zone State Plane Coordinates: Y(Northing) 579,553.49 X(Easting) 1,242,002.07

Precision: 1/20,000 Agency: DCSO Proj. # 2005-2 Date: 1983

Approximate Geographic Position: Latitude 43°13'18" Longitude 123°20'40"


DESCRIPTION and TO REACH

SKETCH

DESCRIPTION:

A brass cap set flush in a concrete sidewalk. **MARKED**  
**OSHD RP EQ+34.80 RT**  
TO REACH:

Go to intersection of NE Stephens St.  
and NE Imbler Ave.

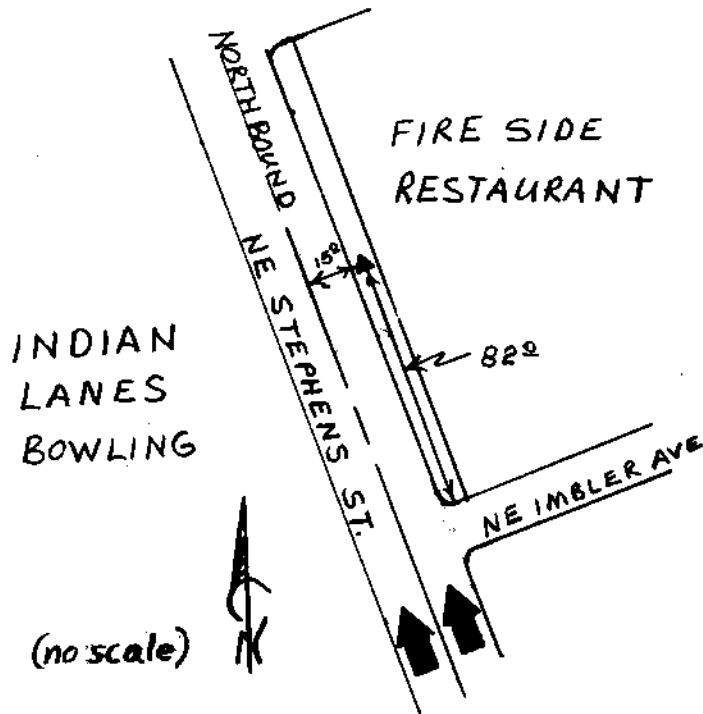

Reference Marks:

Note: For further information, contact the Douglas County Surveyor's Office, Room 205 Douglas County Justice Building, Roseburg, OR 97470. Phone 440-4278. Douglas County residents outside the Roseburg calling area, dial toll free 1-800-452-0991.