


OFFICE OF THE
DOUGLAS COUNTY SURVEYOR

Station: RSBG-17
 Set By (Agency): CITY(RSBG)
 Date Set: ?
 Recovered By KR, TP
 Date Recovered 5/82
 Recovered By RWS-SJF
 Date Recovered 2000
 Recovered By _____
 Date Recovered _____

T 27 S, R 6 W , Sec 23

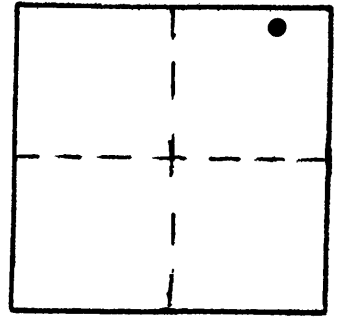

r-069
RSBG 17

27S 6W 23

NAD 576839.45 4156333.02
 83 43°12'49" 123°22'12"

VERTICAL CONTROL NGVD 29

Elevation: ~~439.77~~ 439.59 NGS Line # _____ USGS Line # _____ OSHD Line # _____

Precision: 3rd Agency: CITY(RSBG) Proj. # 66/38 Date: 2000

HORIZONTAL CONTROL OCS 27

DCSO

South Zone State Plane Coordinates: Y(Northing) 576,874.60 X(Easting) 1,235,374.66

Precision: 1/20,000 Agency: DCSO Proj. # 2005-2 Date: 1983

Approximate Geographic Position: Latitude 43°12'49" Longitude 123°22'08"

DESCRIPTION and TO REACH


SKETCH

DESCRIPTION:

A DCSO disk stamped "RSBG 17"
set flush in concrete post.

TO REACH:

Go to entrance of the First United
Methodist Church on W. Harvard Ave.
(1771 W. Harvard)

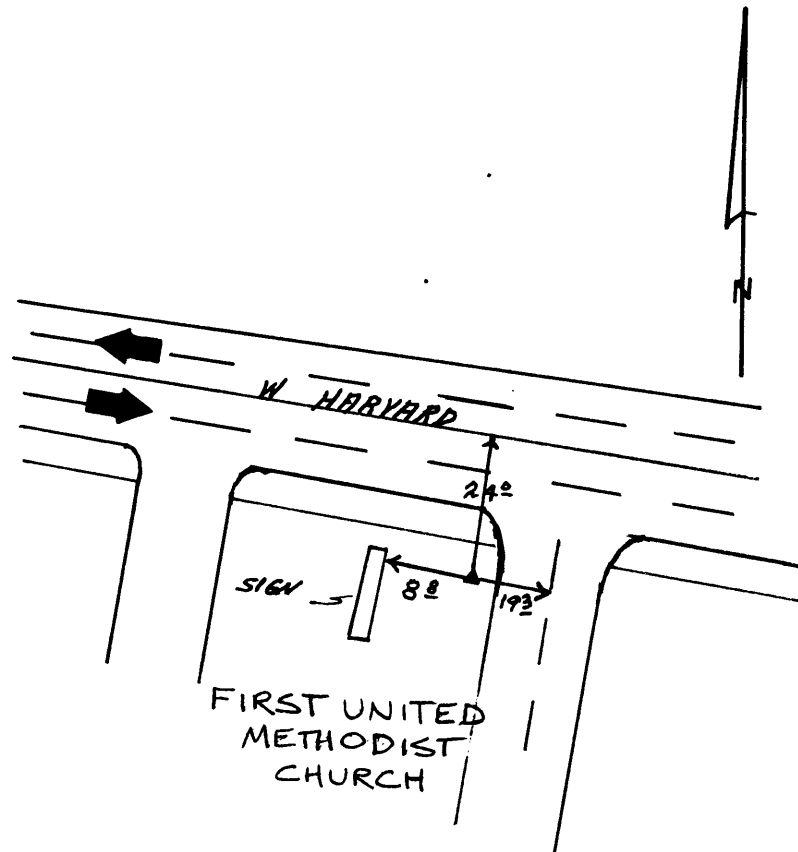

Reference Marks:

Note: For further information, contact the Douglas County Surveyor's Office, Room 205
Douglas County Justice Building, Roseburg, OR 97470. Phone 440-4278. Douglas
County residents outside the Roseburg calling area, dial toll free 1-800-452-0991.