



OFFICE OF THE
DOUGLAS COUNTY SURVEYOR

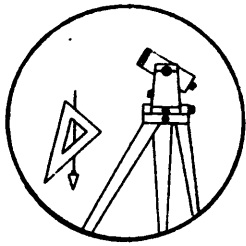

Station: RLF 1 T 27 S, R 6 W, Sec 26
 Set By (Agency): DCPW
 Date Set: 1985
 Recovered By RWS, SJF
 Date Recovered 6/20/85
 Recovered By _____
 Date Recovered _____
 Recovered By _____
 Date Recovered _____

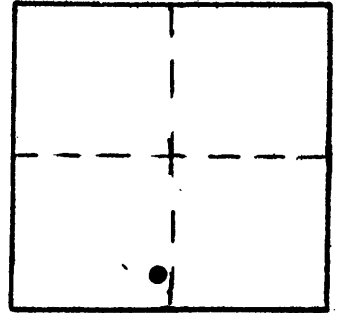

R-072

VERTICAL CONTROL NGVD 29

Elevation: 594.34 NGS Line # _____ USGS Line # _____ OSHD Line # _____
 Precision: 3rd Agency: DCPW Proj. # 2013 Date: 1985

HORIZONTAL CONTROL

South Zone State Plane Coordinates: Y(Northing) _____ X(Easting) _____
 Precision: _____ Agency: _____ Proj. # _____ Date: _____
 Approximate Geographic Position: Latitude _____ Longitude _____


DESCRIPTION and TO REACH

SKETCH

A DCPW disk stamped "RLF 1 BM"
 set in a 6 in. dia. concrete
 filled plastic pipe protruding
 3 in. above ground.

From the intersection of the I-5 on-off ramps
 and McLain Ave. at I-5 Exit 123 in S.35, T27S
 R6W, proceed westerly along McLain Ave. 0.3 mi.
 to monument on right.

ROSEBURG
LAND FILL

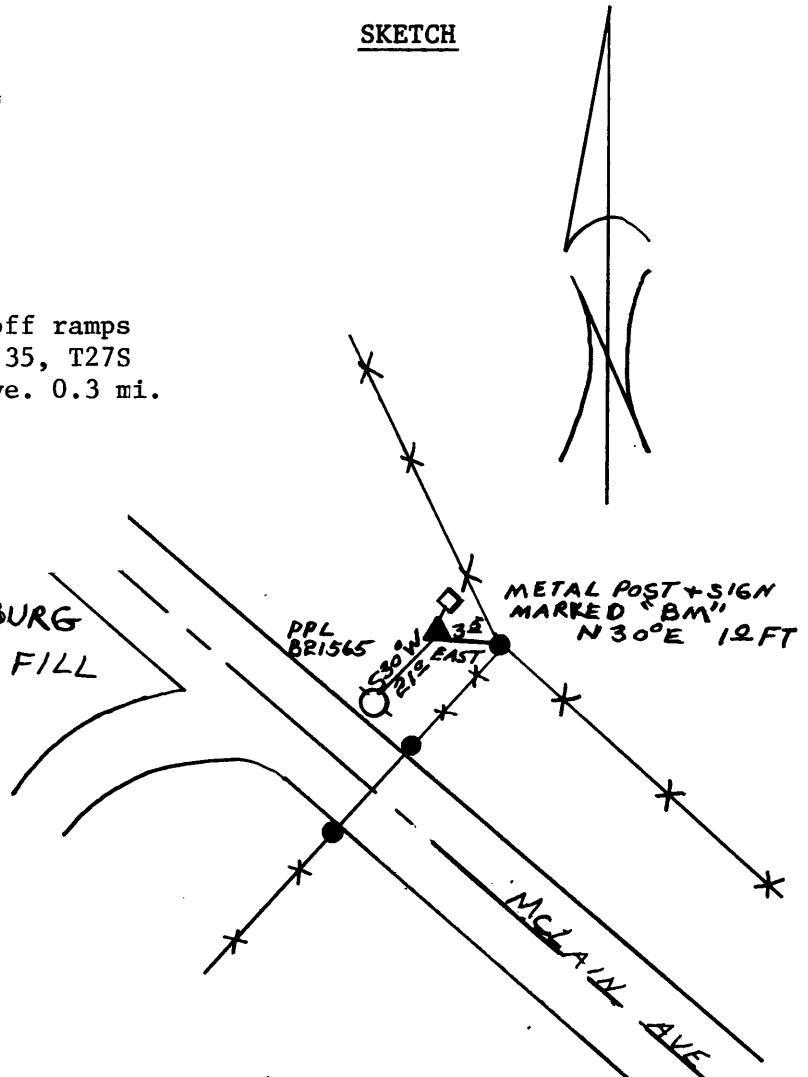

Reference Marks:

Note: For further information, contact the Douglas County Surveyor's Office, Room 205 Douglas County Justice Building, Roseburg, OR 97470. Phone 440-4278. Douglas County residents outside the Roseburg calling area, dial toll free 1-800-452-0991.