

OFFICE OF THE  
DOUGLAS COUNTY SURVEYOR

Station: Reed

T 21 S, R 12W , Sec 34

Date Set: 1989

Set By (Agency): ORDOT

Date Recovered: 8-13-91


Recovered By: TF

Date Recovered: \_\_\_\_\_

Recovered By: \_\_\_\_\_

Date Recovered: \_\_\_\_\_

Recovered By: \_\_\_\_\_

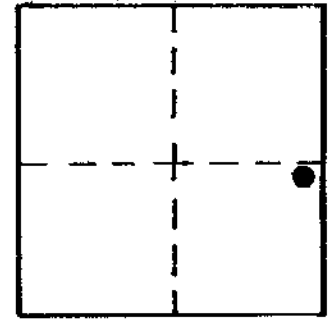

R-083  
REED

21S 12W 34

NAD 762699.96 3968374.83  
83 43°42'11" 124° 6'16"

VERTICAL CONTROL

Elevation: 8.17 NGS Line # \_\_\_\_\_ USGS Line # \_\_\_\_\_ OSHD Line # \_\_\_\_\_

Precision: 3rd Order Agency: NGS Proj. # 83/91 GPS NETWORK Date: 1991

HORIZONTAL CONTROL

South Zone O.C.S. 27: Y(Northing) 762,735.07 X(Easting) 1,047,414.23

South Zone O.C.S. 83: Y(Northing) \_\_\_\_\_ X(Easting) \_\_\_\_\_


Precision: 1/25,000 Agency: DCSO Proj. # GPS 27/83 Date: 1991

Approx. NAD 83 Geographic Position: Latitude \_\_\_\_\_ Longitude \_\_\_\_\_

DESCRIPTION and TO REACH

SKETCH

Found: An ORDOT primary GPS disk stamped "Reed 1989" set in a mass of concrete 8" dia. at ground surface.  
To reach: At the intersection of U.S. Hwy. 101 and St. Hwy 38, on the traffic island east of Hwy 101. Sta mark is 219.88ft east of the centerline of Hwy 101, 12.ft. west of the east edge of the traffic island, and 11 ft. south of the north edge of the island.

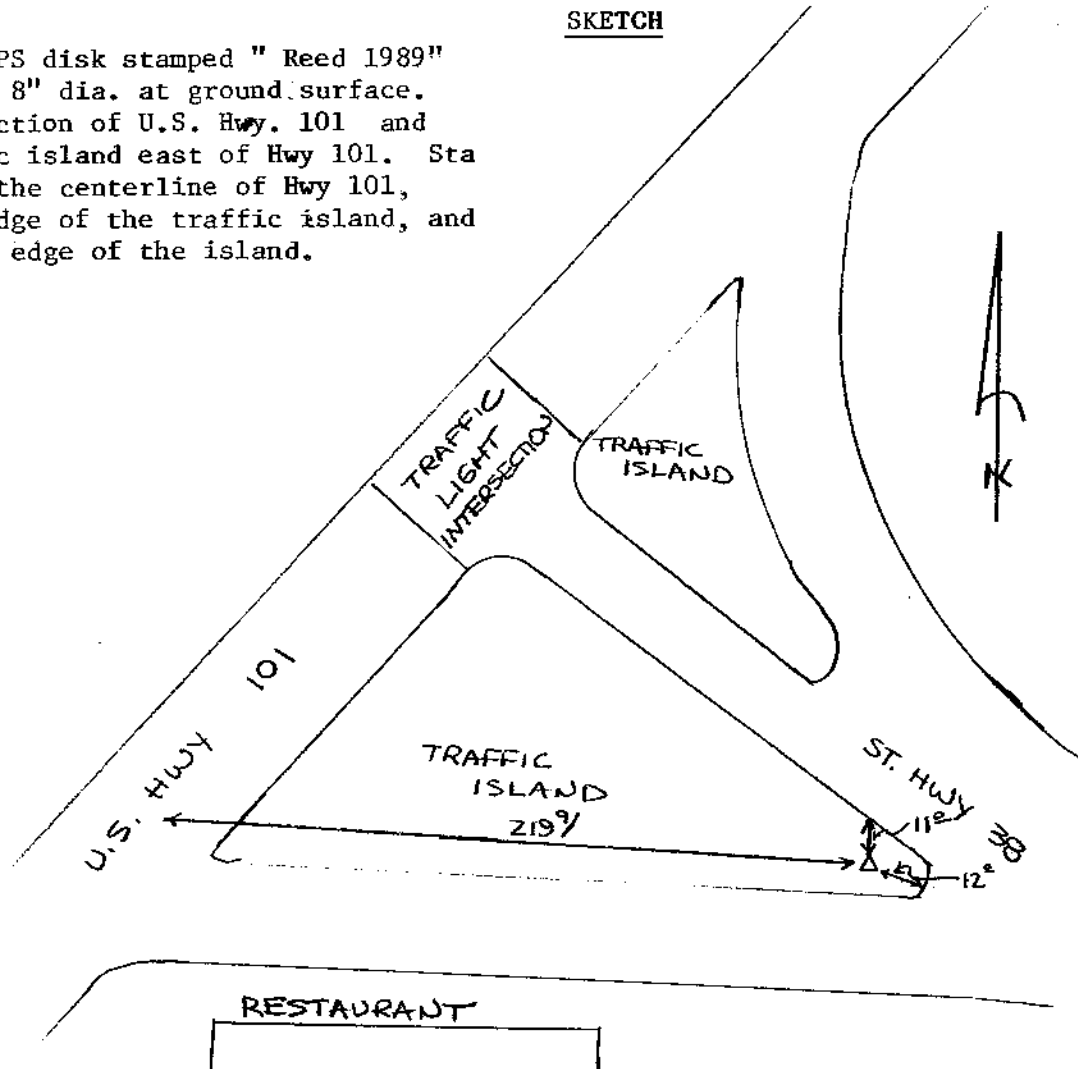

Reference Marks:

Note: For further information, contact the Douglas County Surveyor's Office, Room 205 Douglas County Justice Building, Roseburg, OR 97470. Phone 440-4278. Douglas County residents outside the Roseburg calling area, dial toll free 1-800-452-0991.