

OFFICE OF THE
DOUGLAS COUNTY SURVEYOR

Station: R 747

T31S R5W Sec. 24

Date Set: 1987

Set By (Agency): NGS

DCSO Designation: R-089

Date Recovered: 8-1993



Recovered By: RWS SJF

Date Recovered: _____

Recovered By: _____

Date Recovered: _____

Recovered By: _____

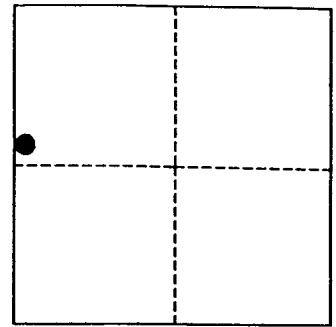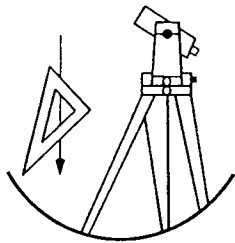

VERTICAL CONTROL

~~NGVD 29~~ ^{NAVD 88} Elevation: 1259.101 FEET NAVD 88 Elevation: 383.774 METERS

NGS Line # 125042 USGS LINE # _____ OSHD Line # _____ FILE # _____

Precision: 1ST ORDER Agency: NGS Proj: _____ Date: 1988

HORIZONTAL CONTROL

~~O.C.S. 27~~ Y(Northing): _____ O.C.S. 83 Y(Northing): 447709

(South Zone) X(Easting): _____ (South Zone) X(Easting): 4185038

Precision: GIS SCALED Agency: DCSO Proj: _____ Date: 2014

Approx. O.C.S. 27 Geographic Position: Latitude: 42°51'42" Longitude: 123°14'44"

Approx. O.C.S. 83 Geographic Position: Latitude: _____ Longitude: _____

Found: A 3 - 5/8 inch diameter NGS disk stamped "R 747 1987" set flush and vertically in large exposed bedrock cutbank.

To reach: From the intersection of Canyon Creek Rd. (Co. Rd. #301) and I-5, exit 95 in T31S R5W Sec2 proceed southerly along I-5 approx. 2.9 miles to milepoint 92.9 and monument on right.

