

write/rain

POS 813

R-095 OFFICE OF THE

DOUGLAS COUNTY SURVEYOR

Station: Romie



T 23 S, R 4W, Sec 21

Date Set: 1997

Set By (Agency): DCSO

Date Recovered: 2-11-97

Recovered By: RWS SJF

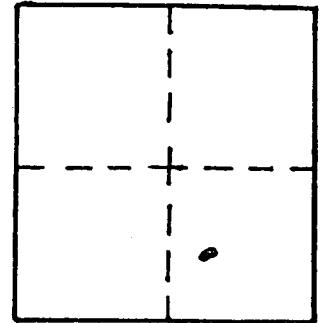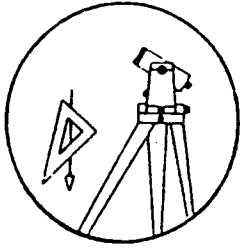

- Found
- New
- Reset
- Not Found
- Referenced
- Destroyed

VERTICAL CONTROL

Elevation: 839.74 NGS Line # _____ USGS Line # _____ OSHD Line # _____

Precision: 3rd Agency: DCSO Proj. # 2007 Date: 1997

HORIZONTAL CONTROL CORPSCON6 NAVD88 843.44 FT. CS66/54

South Zone O.C.S. 27: Y(Northing) _____ X(Easting) _____

South Zone O.C.S. 83: Y(Northing) 698000 X(Easting) 4212494

Precision: GIS SCALED Agency: DCSO Proj. # _____ Date: 2014

Approx. 1927 Geographic Position: Latitude 43° 33' 04" Longitude 123° 10' 22"

DESCRIPTION and TO REACH

A DCSO ^{3" DIA} V PILL CAP IS SET IN A 8" DIA 42" LONG CONCRETE FILLED BELL TILE, PROTRUSING 6" ABOVE GROUND

GO TO THE INTERSECTION OF ROMIE HOWARD RD (CO. RD #69) AND SCOTTS VALLEY RD (CO. RD #8) IN T23S R4W SEC 21, PROCEED SOUTHWESTERLY ALONG ROMIE HOWARD RD APPROX 100 FT TO MONUMENT ON RIGHT.

Reference Marks:

