



OFFICE OF THE  
DOUGLAS COUNTY SURVEYOR

Station: REINA  
Date Set: 1997  
Set By (Agency): DCSO  
Date Recovered: 2/19/97  
Recovered By: RWS, SJF

T 235 S, R 4W, Sec 15

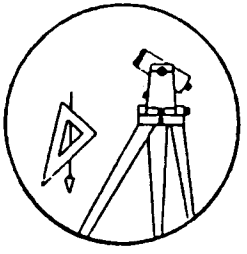

- Found
- New
- Reset
- Not Found
- Referenced
- Destroyed

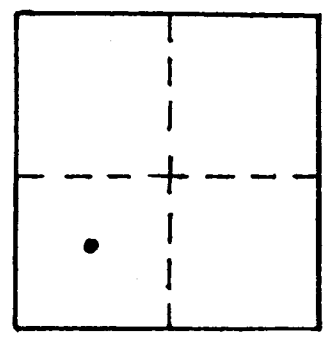

VERTICAL CONTROL

Elevation: 956.71 NGS Line # \_\_\_\_\_ USGS Line # \_\_\_\_\_ OSHD Line # \_\_\_\_\_  
Precision: 3rd Agency: DCSO Proj. # 2007 Date: 1997

HORIZONTAL CONTROL CORPSCON6 NAVD88 960.41 FT CS 66/54

South Zone O.C.S. 27: Y(Northing) \_\_\_\_\_ X(Easting) \_\_\_\_\_

South Zone O.C.S. 83: Y(Northing) 703729 X(Easting) 4216071

Precision: GIS SCALED Agency: DCSO Proj. # \_\_\_\_\_ Date: 2014

Approx. 1927 Geographic Position: Latitude 43° 34' 01" Longitude 123° 09' 36"

DESCRIPTION and TO REACH

A DCSO DISK STAMPED "REINA 1997" SET FLUSH IN TOP OF 8 INCH DIAMETER 30 INCH LONG CONCRETE FILLED BELL-TILE SET PROTRUDING APPROXIMATELY 3 INCHES ABOVE GROUND.

FROM THE INTERSECTION OF LONDON HILL RD (CO. RD. # 8A) AND SCOTTS VALLEY RD. (CO. RD. # 8) IN T235, R4W, SEC 3 PROCEED SOUTHERLY ALONG SCOTTS VALLEY RD. APPROXIMATELY 2.75 MILES TO MONUMENT ON RIGHT.

Reference Marks:

---



---



PPL  
4  
153  
1

