


Douglas County Geodetic Data Sheet

T 29 R 06 WS 19 C

Station: RC-8
 Date Set: 1998 Set By (Agency): DCSO
 Last Date Recovered: 12/00/2000

Designation: R-104

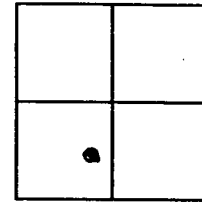

VERTICAL CONTROL

NGVD 29 Elevation: 836.13 Feet

Precision: 3RD ORDER Agency: DCSO

CS File: 66055

Date: 1998

NAVD 88 Elevation: 839.63 FT.

Precision: CORPSCON6 Agency: NAVD88

CS File:

Date:

HORIZONTAL CONTROL

OCS 27 Y(Northing): X(Easting): Lat 43° 01' 54.0" Long: 123° 27' 12.0"

Precision: GIS Agency: CS File: Date:

OCS 83 Y(Northing): 511370 X(Easting): 4131495 Lat Long:

Precision: GIS SCALED Agency: DCSO CS File: Date: 2014

OCS 83/91 Y(Northing): X(Easting): Lat Long:

Precision: Agency: CS File: Date:

OCS 83/98 Y(Northing): X(Easting): Lat Long:

Precision: Agency: CS File: Date:


Description: Scaled Lat 43° 01' 54" Long: 123° 27' 12"

A DCSO BRASS CAP STAMPED; RC-8 1998; SET IN NORTHEAST WING WALL OF CONCRETE BRIDGE OVER SMALL CREEK.

Comments:

FROM THE INTESECTION OF RICE CREEK RD;
 CO. RD 43A; AND WILLIS CREEK ROAD; CO.RD
 43; IN T29S R6W SEC.4; PROCEED
 SOUTHWESTERLY ALONG RICE CREEK RD 4.4
 MILES TO BRIDGE OVER SMALL CREEK AND
 MONUMENT ON RIGHT.

Notes:

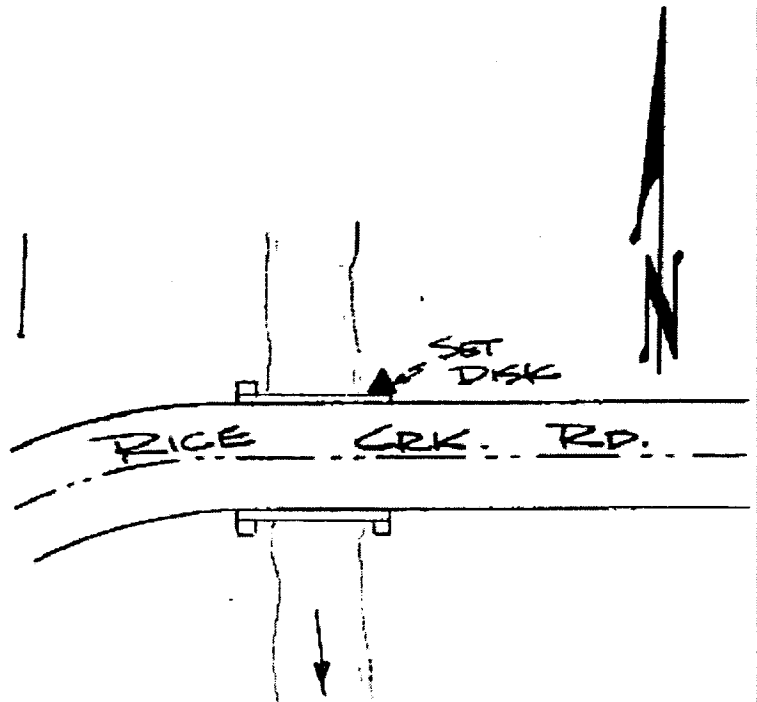

Note: For further information contact the Douglas County Surveyors Office, Room 105A Douglas County Courthouse, Roseburg, OR 97470. Phone 440-4272 or Fax (541)957-8150. Douglas County Residents outside Roseburg calling area, dial toll free 1-800-224-1619.