


DOUGLAS COUNTY SURVEYOR'S OFFICE

Designation: R-113 Station: R76 RESET T 29S R 8W S 20 1/4 NW

Date Set: 2007 Set by (Agency): DCSO

Date Recovered: 7/25/07 Recovered by: RWS SJF

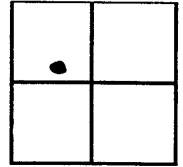

- Found New Reset
 Not Found Referenced Destroyed

VERTICAL CONTROL

NGVD 29 Elevation: 1131.124 Feet File # —
 Precision: RND Agency: DCSO Project: — Date: 2007
 NAVD 88 Elevation: _____ Meters File # _____
 Precision: _____ Agency: _____ Project: _____ Date: _____


HORIZONTAL CONTROL - south zone

N _____ E _____ Datum/Adj.: _____ Precision: _____
 Lat: _____ Long: _____ Agency: _____ File # _____ Date: _____
 N _____ E _____ Datum/Adj.: _____ Precision: _____
 Lat: _____ Long: _____ Agency: _____ File # _____ Date: _____
 N _____ E _____ Datum/Adj.: _____ Precision: _____
 Lat: _____ Long: _____ Agency: _____ File # _____ Date: _____
 N _____ E _____ Datum/Adj.: _____ Precision: _____
 Lat: _____ Long: _____ Agency: _____ File # _____ Date: _____

DESCRIPTION AND TO REACH

DCSO DRILL CAP STAMPED "R76
RESET 2007" SET AT NW
CORNER OF CONCRETE CATCH
Basin.

FROM THE INTERSECTION OF
STATE HWY 42 AND MAIN
CAMAS ROAD IN T29S R8W
SEC 20 (AT CAMAS VALLEY)
PROCEED SOUTHWESTERLY ALONG
MAIN CAMAS ROAD APPROX.
300 FT TO MONUMENT ON
RIGHT IN CONCRETE
CATCH BASIN.

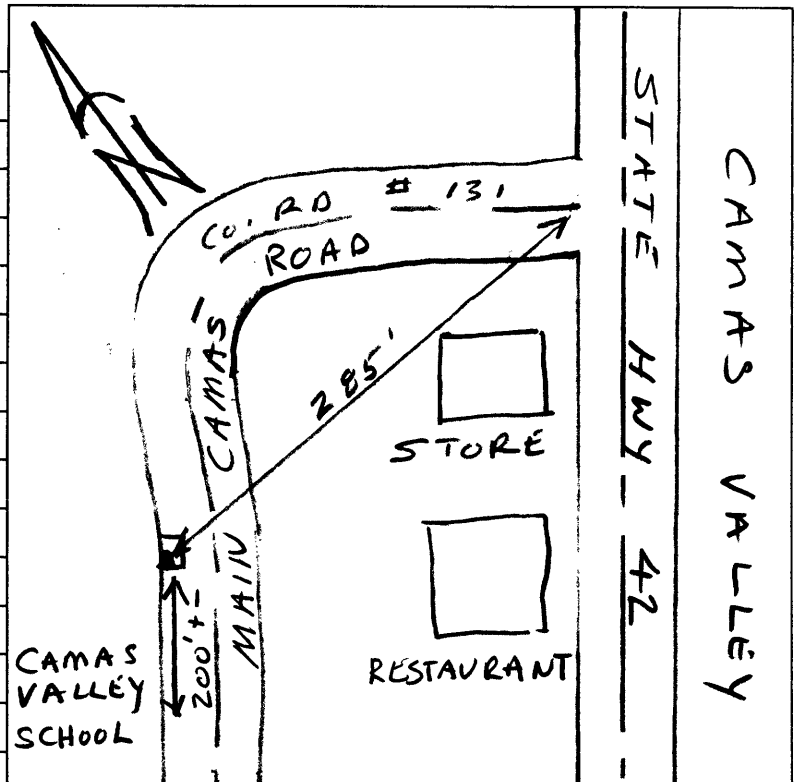



STOP
AHEAD

7. 25. 2007