

OFFICE OF THE
DOUGLAS COUNTY SURVEYOR

Station: S-1 T 21 S, R 12W , Sec 25

Set By (Agency): DCSO

Date Set: 1973

Recovered By G.Q. - RWS


Date Recovered 1-20-82

Recovered By _____

Date Recovered _____

Recovered By _____

Date Recovered _____

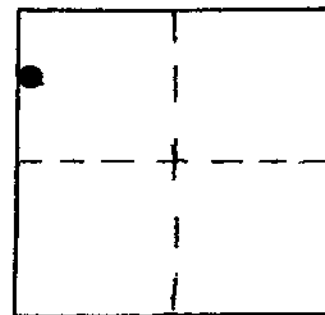

S-001
S-1

21S 12W 25

NAD 769253.27 3974565.17
83 43°43'19" 124° 4'56"

VERTICAL CONTROL

Elevation: _____ NGS Line # _____ USGS Line # _____ OSHD Line # _____

Precision: _____ Agency: _____ Proj. # _____ Date: _____

HORIZONTAL CONTROL

South Zone State Plane Coordinates: Y(Northing) 769,288.50 X(Easting) 1,053,604.57

Precision: 1/25,000 Agency: DCSO Proj. # 2006 Date: 1973


Approximate Geographic Position: Latitude 43°43'19" Longitude 124°04'52"

DESCRIPTION and TO REACH

SKETCH

Found standard DCSO disk set in concrete tile protruding 8" out of the ground marked "S-1 1973".

To reach: From the intersection of Hwy 101 and Co. Rd. #48 (in sec. 26 T21S, R12W) proceed easterly along rd. #48 1.05 mi. to station on the right.

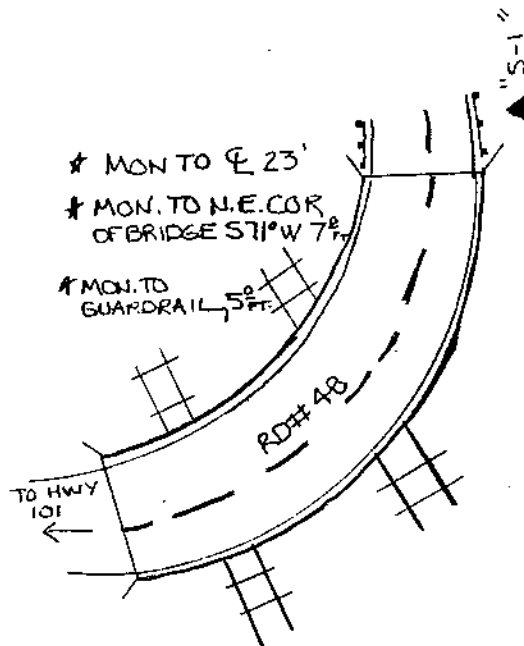

Reference Marks:

Note: For further information, contact the Douglas County Surveyor's Office, Room 205 Douglas County Justice Building, Roseburg, OR 97470. Phone 440-4278. Douglas County residents outside the Roseburg calling area, dial toll free 1-800-452-0991.