

OFFICE OF THE
DOUGLAS COUNTY SURVEYOR

Station: S-8 T 20 S, R 11W , Sec 35

Set By (Agency): DCSO

Date Set: 1973

Recovered By GQ-TP


Date Recovered 1-27-82

Recovered By _____

Date Recovered _____

Recovered By _____

Date Recovered _____

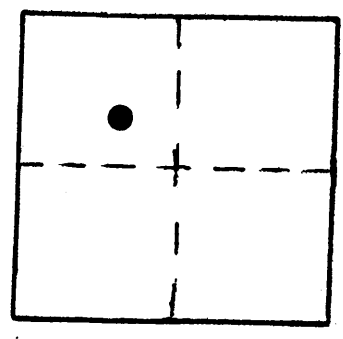

S-009
S-8 20S 11W 35

NAD 793117.07 4002500.22
83 43°47'26" 123°58'50"

VERTICAL CONTROL NVGD 29

Elevation: 14.428 NGS Line # _____ USGS Line # _____ OSHD Line # _____

Precision: 2nd Agency: DCSO Proj. # 2006 Date: 1973

HORIZONTAL CONTROL NAD 27

South Zone State Plane Coordinates: Y(Northing) 793,152.55 X(Easting) 1,081,539.95

Precision: 1/25,000 Agency: DCSO Proj. # 2006 Date: 1973


Approximate Geographic Position: Latitude 43°47'26" Longitude 123°58'45"

DESCRIPTION and TO REACH

Found: A standard DCSO disk set in large boulder flush with the ground stamped "S-8 1973". Survey marker sign South of monument 3 ft.

To reach: From the intersection of Co.Rd. #48A & Co.Rd. #48 (in sec 31 T20S R10W) proceed Southwesterly along Rd. #48, 5.65 mi. to monument on the left.

SKETCH

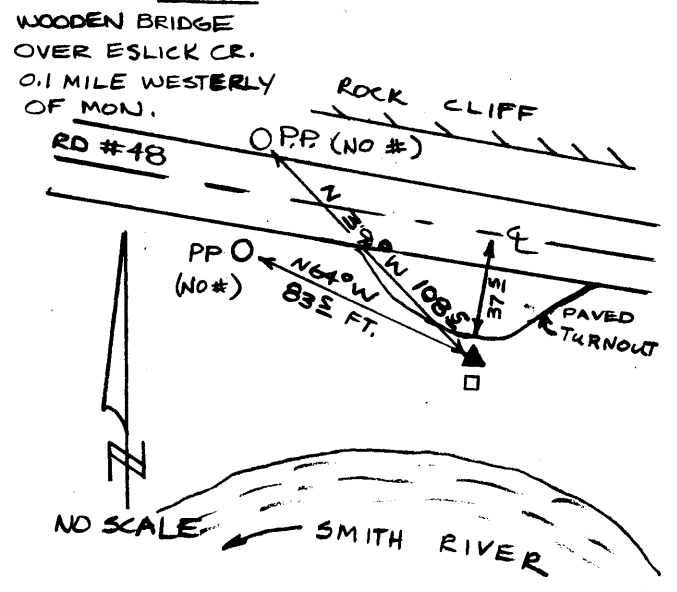

Reference Marks:

Note: For further information, contact the Douglas County Surveyor's Office, Room 205 Douglas County Justice Building, Roseburg, OR 97470. Phone 440-4278. Douglas County residents outside the Roseburg calling area, dial toll free 1-800-452-0991.