
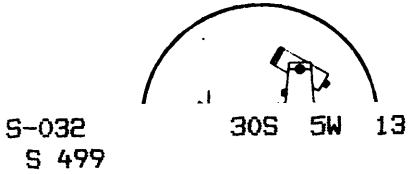


OFFICE OF THE  
DOUGLAS COUNTY SURVEYOR

Station: S 499 T 30 S, R 5W, Sec 13  
 Set By (Agency): USC&GS  
 Date Set: 1949  
 Recovered By RS-JP  
 Date Recovered 3-17-82  
 Recovered By TF  
 Date Recovered 1-31-92  
 Recovered By \_\_\_\_\_  
 Date Recovered \_\_\_\_\_

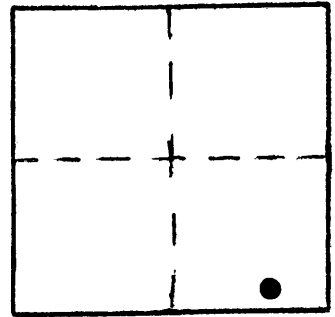

NAD 482167.09 4189809.43  
 83 42°57'25" 123°13'59"

VERTICAL CONTROL NGVD 29

Elevation: 721.360 NGS Line # 130 USGS Line # \_\_\_\_\_ OSHD Line # \_\_\_\_\_  
 Precision: 2nd Agency: USC&GS Proj. # \_\_\_\_\_ Date: 1957

HORIZONTAL CONTROL OCS 27


South Zone State Plane Coordinates: Y(Northing) 482,203.03 X(Easting) 1,268,850.93  
 Precision: 1/25,000 Agency: DCSO Proj. # 2008 Date: 1992  
 Approximate Geographic Position: Latitude \_\_\_\_\_ Longitude \_\_\_\_\_

DESCRIPTION and TO REACH

SKETCH

Found: A standard USC&GS disk stamped "S 499 1949" set in a 12" diam. concrete post flush with the ground.

To reach: From the intersection of St. Hwy. 227 and Co. Rd. #42 (Days Creek cut off) in T30S R4W sec. 7 proceed Westerly along St. Hwy. 227 1.55 miles to monument on the left. MP 7.5

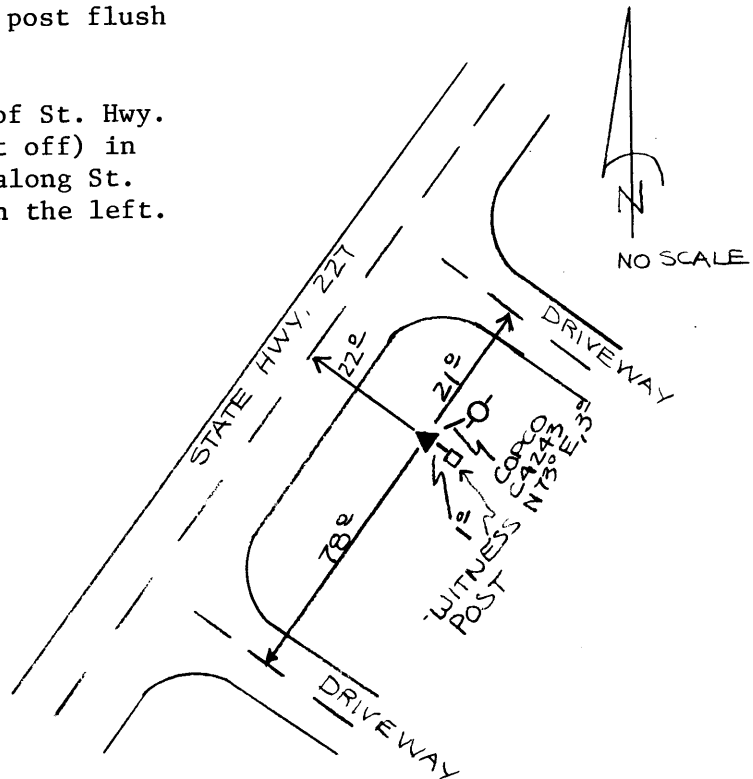

Reference Marks:

Note: For further information, contact the Douglas County Surveyor's Office, Room 205 Douglas County Justice Building, Roseburg, OR 97470. Phone 440-4278. Douglas County residents outside the Roseburg calling area, dial toll free 1-800-452-0991.