

2/82


s-038  
S 596

27S 6W 13

OFFICE OF THE

DOUGLAS COUNTY SURVEYOR

NAD 581685.83 4158832.29  
83 43°13'37" 123°21'41"

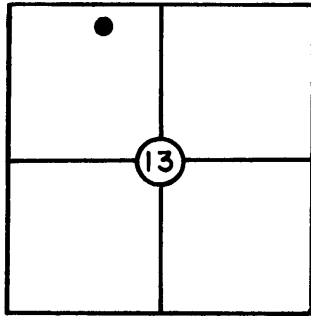

T 27 S, R 6 W, Sec. 13

Station: S 596

Set By (Agency): OSHD

Date: 1965

VERTICAL CONTROL **NGVD 29**

Elevation: 497.04 ~~NSS (USC&GS)~~ <sup>OSHD</sup> Line # 369 USGS Line # \_\_\_\_\_

Order Of Precision 3rd Agency: OSHD Proj. #: \_\_\_\_\_ Date: 1977

HORIZONTAL CONTROL **OCS 27**

Oregon State Plane Coordinates: Y(Northing) 581,720.99 X(Easting) 1,237,873.97  
(South Zone)

Order Of Precision 1/25,000 Agency: DCSO Proj. #: 2004-20 Date: 1980  
CS# 61/10

Approximate Geographic Position: Latitude= 43°13'38" Longitude= 123°21'37"

DESCRIPTION: A brass cap set in conc.

curbing stamped "S 596 1965". 0.65 ft.


above the pavement, 0.5 ft. from edge of

walkway, 3.35 ft. from West edge of same

walkway.

VICINITY: Northwest end of conc. walkway  
on North side of Garden Valley Blvd over-  
pass crossing "I-5".

SKETCH

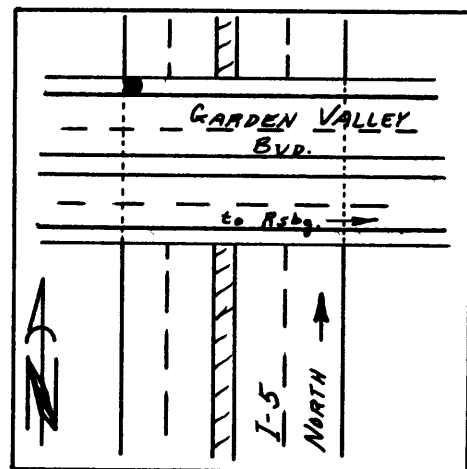

NOTE: For Possible Further Information On This Station, Please Contact The Douglas County Surveyors Office, Rm. 205 Douglas County Justice Bldg., Roseburg, OR. 97470 Phone 672-3311 Ext. 272. Douglas County residents outside the Roseburg calling area dial toll free 1-800-452-0991.