


OFFICE OF THE
DOUGLAS COUNTY SURVEYOR

s-063 225 12W 33
SC-14
NAD 734402.43 3959345.91
83 43°37'28" 124° 8' 3"

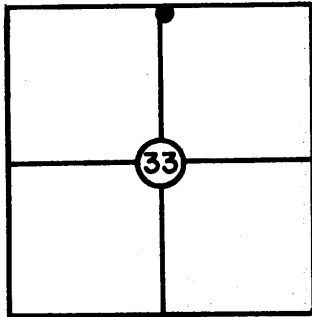

T 22 S, R 12W, Sec. 33

Station: SC-14

Set By (Agency): DCSO

Date: 1975

RECOVERED 3-23-82

VERTICAL CONTROL

Elevation: _____ NGS(USC&GS) Line # _____ USGS Line # _____

Order
Of Precision _____ Agency: _____ Proj. #: _____ Date: _____

HORIZONTAL CONTROL


DCS 27
Oregon State Plane Coordinates: Y(Northing) 734,437.51 X(Easting) 1,038,385.13
(South Zone)

Order
Of Precision 1/25,000 Agency: DCSO Proj. #: 6004-16 Date: 1976

Approximate Geographic Position: Latitude=43° 37' 29" Longitude=124° 07' 58"

DESCRIPTION: Standard brass cap in 3 ft.
belltile set 12 ft. E. of centerline of R.R.
track. Sta. is 16 ft. NE of centerline of
Scholfield Cr. Rd. witness post 3 ft. E. from
cap to reach from Hwy. #38 turn left on Sch-
olfield Cr. Rd. & Cont. 8.4 mi. to R.R.
crossing. Witness post visible.

VICINITY: Approx. 8.4 mi. up Scholfield Crk.
Rd.

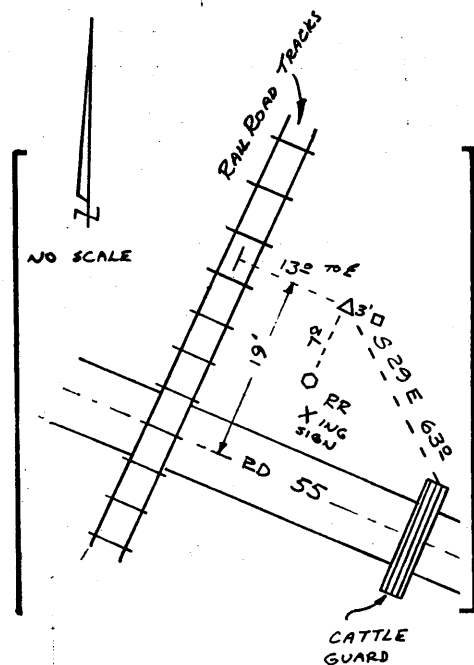

NOTE: For Possible Further Information On This Station, Please Contact The Douglas County Surveyors Office, Rm. 205 Douglas County Justice Bldg., Roseburg, OR. 97470 Phone 672-3311 Ext. 272.. Douglas County residents outside the Roseburg calling area dial toll free 1-800-452-0991.