

OFFICE OF THE
DOUGLAS COUNTY SURVEYOR

Station: SCOTT
Set By (Agency): USC&GS
Date Set: 1904
Recovered By RWS
Date Recovered 9/14/89
Recovered By _____
Date Recovered _____
Recovered By _____
Date Recovered _____


T 25 S, R 3 W , Sec 28



s-069
SCOTT

25S 3W 28

NAD 632035.52 4239425.97
83 43°22'20" 123° 3' 54"

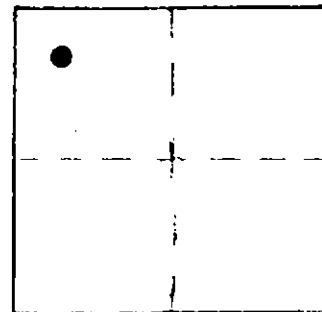

VERTICAL CONTROL

Elevation: 4252 NGS Line # _____ USGS Line # _____ OSHD Line # _____
Precision: VA Agency: DCSO Proj. # 2001 Date: 1971


HORIZONTAL CONTROL

South Zone State Plane Coordinates: Y(Northing) 632,071.28 X(Easting) 1,318,465.56
Precision: 1/100,000 Agency: DCSO Proj. # 2001 Date: 1973
Approximate Geographic Position: Latitude 43°22'21" Longitude 123°03'49"

DESCRIPTION and TO REACH

A 3 1/8" dia. bronze ring with a 1/2" recessed 1 1/2" dia. bronze disk marked at center with a "+" set in rock.

From the intersection of state hwy. 138 and Rock creek rd. (Co.Rd.#78) in T26S,R3W,Sec.1, proceed northeasterly along Rock creek rd. approx. 2.3 miles to Kelly creek rd. (BLM Rd.# 25-3-36), in T25S,R3W,Sec.36, proceed westerly along Kelly creek rd. 3.7 miles to road on right, take right fork to summit, lookout, and monuments.

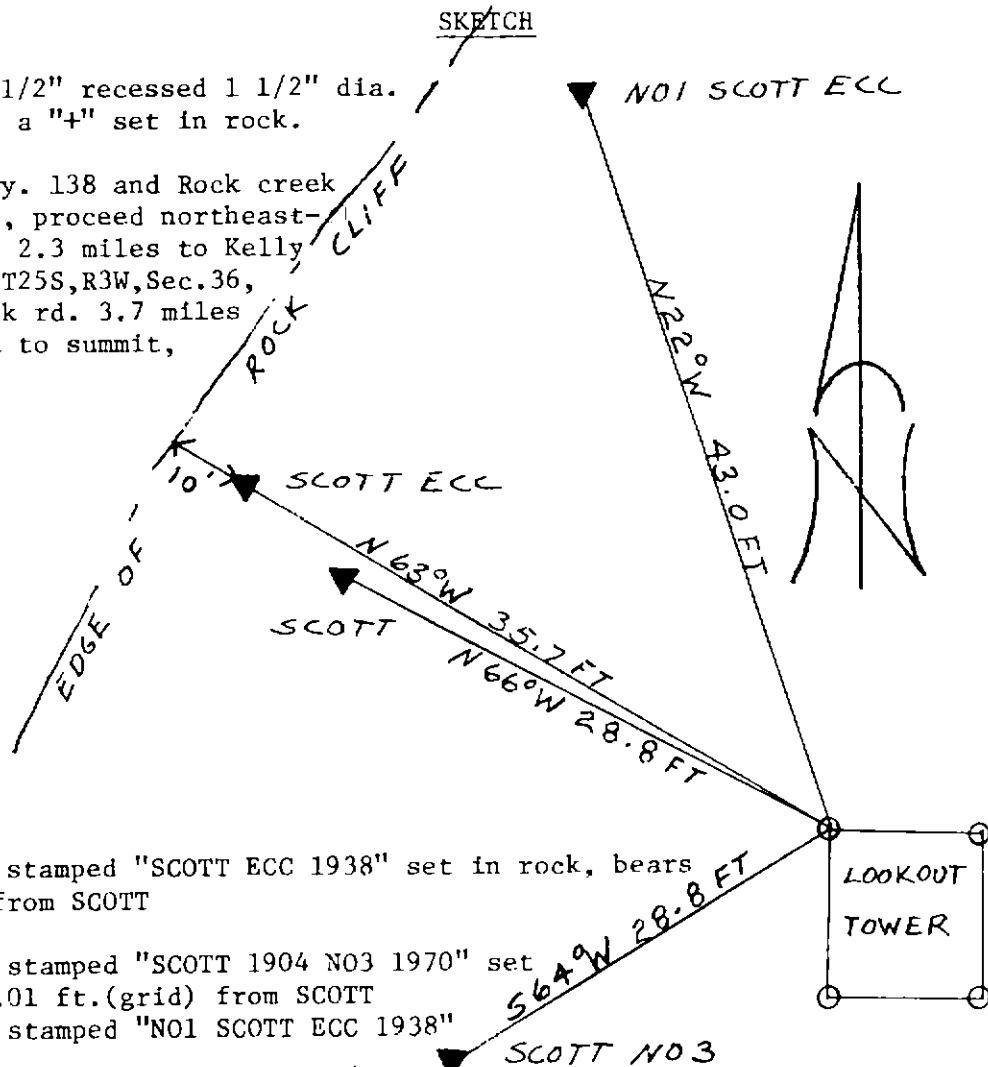

Reference Marks:

A USC&GS 3 1/8" dia. bronze disk stamped "SCOTT ECC 1938" set in rock, bears N 48°11'43" W, 7.23 ft. (grid). from SCOTT

A USC&GS 3 1/2" dia. bronze disk stamped "SCOTT 1904 NO3 1970" set in rock, bears S 13°54'40" E, 20.01 ft.(grid) from SCOTT

A USC&GS 3 1/2" dia. bronze disk stamped "NO1 SCOTT ECC 1938" set in rock northeast of SCOTT.

Note: For further information, contact the Douglas County Surveyor's Office, Room 205 Douglas County Justice Building, Roseburg, OR 97470. Phone 440-4278. Douglas County residents outside the Roseburg calling area, dial toll free 1-800-452-0991.