


OFFICE OF THE
DOUGLAS COUNTY SURVEYOR

Station: SH-2B T 27 S, R 6 W, Sec 22
Set By (Agency): CITY (RSBG)
Date Set: ?
Recovered By KR, TP
Date Recovered 5/82
Recovered By RWS SJF
Date Recovered 2000
Recovered By _____
Date Recovered _____

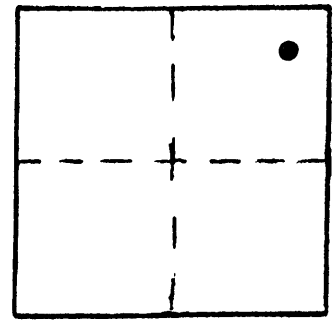

S-077
SH-2B

275 6W 22

NAD 576532.56 4150316.70
83 43°12'44" 123°23'33"

NGVD 29

VERTICAL CONTROL

Elevation: 429.19 NGS Line # _____ USGS Line # _____ OSHD Line # _____
Precision: 3rd Agency: DCSO Proj. # 66/38 Date: 2000

HORIZONTAL CONTROL OCS 27

South Zone State Plane Coordinates: Y(Northing) 576,567.67 X(Easting) 1,229,358.31
Precision: 1/20,000 Agency: DCSO Proj. # 2005-2 Date: 1983
Approximate Geographic Position: Latitude 43°12'44.2" Longitude 123°23'29.2"

DESCRIPTION and TO REACH


SKETCH

DESCRIPTION:

A disk street monument set below pavement with access cover above.

TO REACH:

Go to intersection of W. Lorraine Ave. and W. Hickory St.

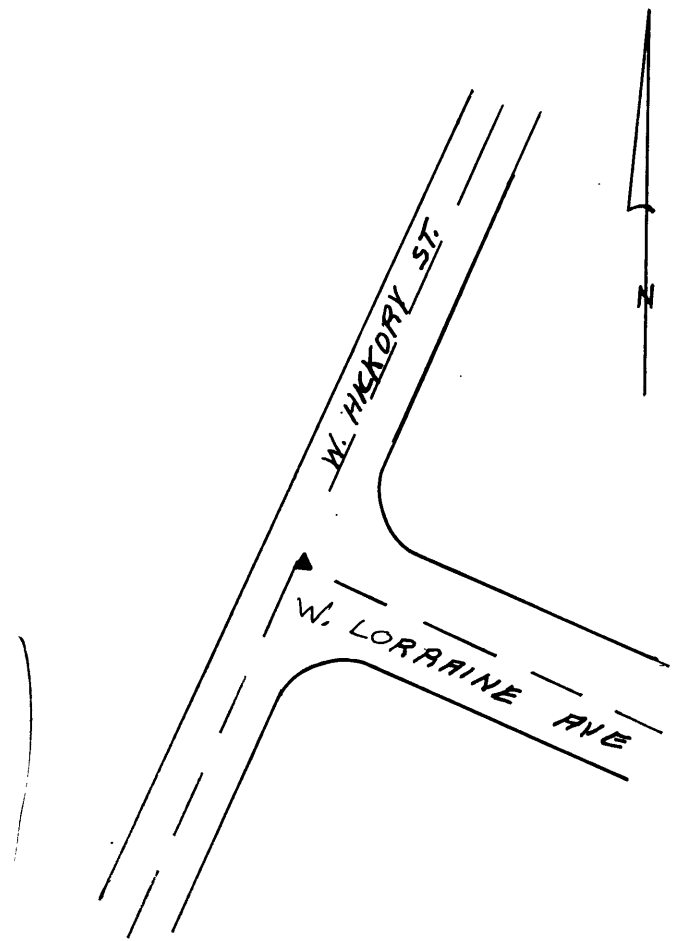

Reference Marks:

Note: For further information, contact the Douglas County Surveyor's Office, Room 205 Douglas County Justice Building, Roseburg, OR 97470. Phone 440-4278. Douglas County residents outside the Roseburg calling area, dial toll free 1-800-452-0991.