
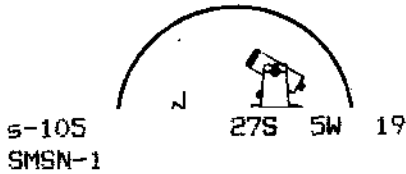


OFFICE OF THE
DOUGLAS COUNTY SURVEYOR

Station: SMSN-1
 Set By (Agency): CITY(RSBG)
 Date Set: ?
 Recovered By TP,JP
 Date Recovered 8/82
 Recovered By _____
 Date Recovered _____
 Recovered By _____
 Date Recovered _____

T 27 S, R 5 W , Sec 19

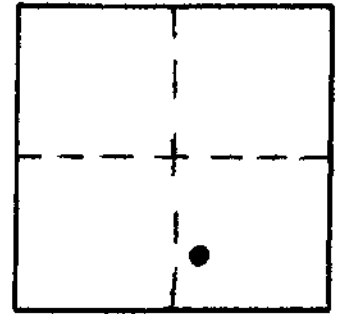

NAD 572940.18 4165899.13
 83 43°12'13" 123°20' 2"

VERTICAL CONTROL

Elevation: _____ NGS Line # _____ USGS Line # _____ OSHD Line # _____
 Precision: _____ Agency: _____ Proj. # _____ Date: _____

HORIZONTAL CONTROL OCS 27

South Zone State Plane Coordinates: Y(Northing) 572,975.41 X(Easting) 1,244,940.80
 Precision: 1/20,000 Agency: DCSO Proj. # 2005-2 Date: 1983
 Approximate Geographic Position: Latitude 43°12'14" Longitude 123°19'57"

DESCRIPTION and TO REACH


SKETCH

DESCRIPTION:

A disk street monument set below pavement with access cover above.

TO REACH:

From the intersection of SE Summit Dr. and SE Terrace Dr. proceed Northerly along SE Summit Dr. 0.10 miles to station in centerline of road.

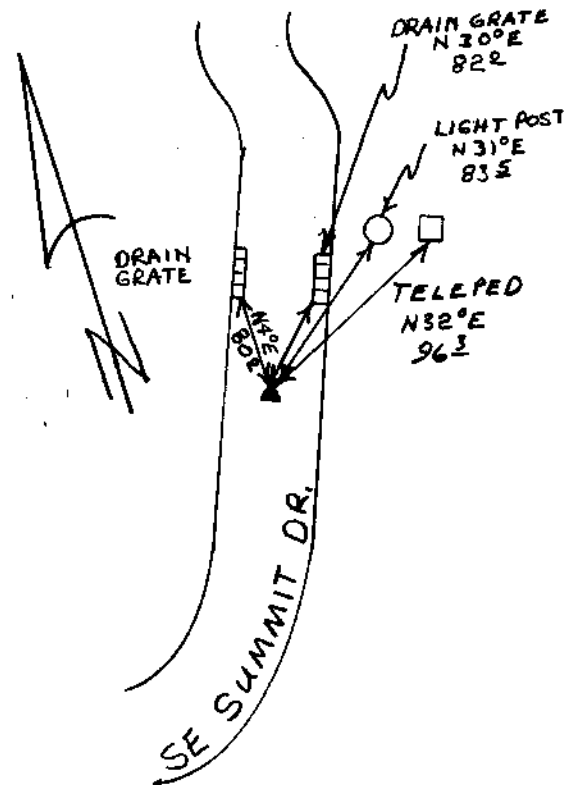

Reference Marks:

Note: For further information, contact the Douglas County Surveyor's Office, Room 205 Douglas County Justice Building, Roseburg, OR 97470. Phone 440-4278. Douglas County residents outside the Roseburg calling area, dial toll free 1-800-452-0991.