


OFFICE OF THE
DOUGLAS COUNTY SURVEYOR



S-12³

Station: SR-8. T 21 S, R 12W , Sec 23
 Set By (Agency): 1955
 Date Set: CORP. OF ENG.
 Recovered By GQ- RWS
 Date Recovered 1-20-82
 Recovered By _____
 Date Recovered _____
 Recovered By _____
 Date Recovered _____

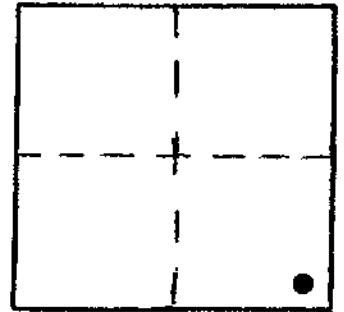

VERTICAL CONTROL

Elevation: 17.46 NGS Line # _____ USGS Line # _____ OSHD Line # _____
 Precision: 3rd Agency: DCSO Proj. # 2006 Date: 1989

HORIZONTAL CONTROL


South Zone State Plane Coordinates: Y(Northing) _____ X(Easting) _____
 Precision: _____ Agency: _____ Proj. # _____ Date: _____
 Approximate Geographic Position: Latitude _____ Longitude _____

DESCRIPTION and TO REACH

Found: Copper nail and washer cemented in a 2" pipe protruding 3" out of the ground. Washer is stamped "SR 8 1955". Corp of Eng. survey marker sign is just West of the monument.

To reach: From the intersection of Hwy 101 and Co. Rd. #48 (in T21S R12W sec. 26) proceed easterly along Rd. # 48 1.3 miles to monument on the left.

SKETCH

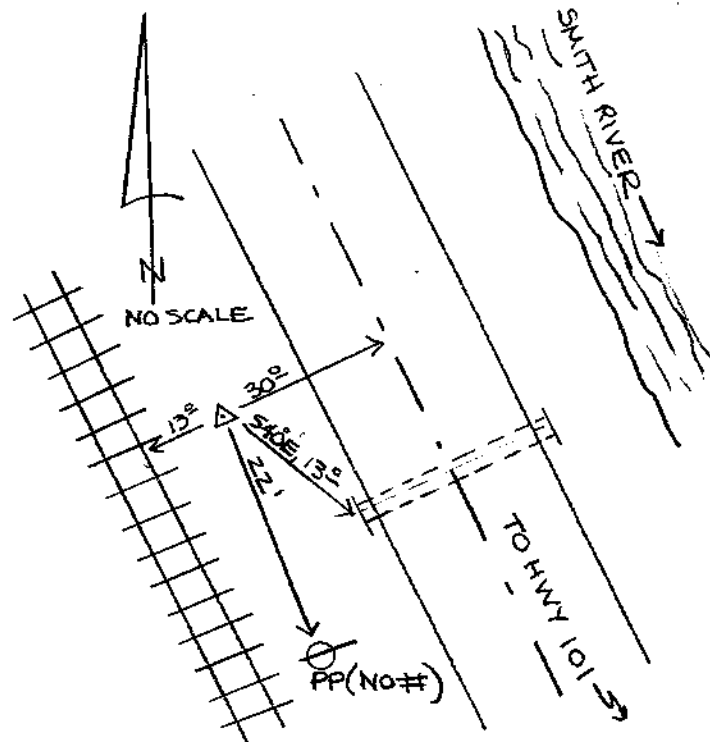

Reference Marks:

Note: For further information, contact the Douglas County Surveyor's Office, Room 205 Douglas County Justice Building, Roseburg, OR 97470. Phone 440-4278. Douglas County residents outside the Roseburg calling area, dial toll free 1-800-452-0991.