

OFFICE OF THE
DOUGLAS COUNTY SURVEYOR

Station: S. SWIFT T 26 S, R 3 W, Sec 1

Set By (Agency): FED. HWY. ADMIN.

Date Set: _____

Recovered By RWS, SIF


Date Recovered 11/21/84

Recovered By _____

Date Recovered _____

Recovered By _____

Date Recovered _____

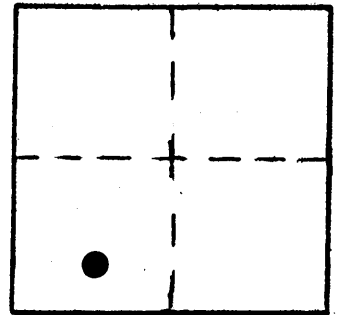

s-125
S. SWIFT 265 3W 1

NAD 616950.41 4254732.58
83 43°19'56" 123° 0'20"

VERTICAL CONTROL

Elevation: _____ NGS Line # _____ USGS Line # _____ OSHD Line # _____

Precision: _____ Agency: _____ Proj. # _____ Date: _____

HORIZONTAL CONTROL NAD 27

South Zone State Plane Coordinates: Y(Northing) 616,986.33 X(Easting) 1,333,772.13

Precision: 1/15,000 Agency: DCSO Proj. # 6010-4 CS#60/7 Date: 1978

Approximate Geographic Position: Latitude 43°19'56" Longitude 123°00'16"


DESCRIPTION and TO REACH

A FED. HWY. ADMIN. disk stamped "S. SWIFT 1978" set in the southwest corner of bridge over the N. Umpqua river. It is set in the curb 1 ft. above the bridge deck.

TO REACH:

Go to the intersection of North Umpqua Hwy. (State Hwy. #138) and Swiftwater Rd. (USFS Rd. #26-3-1.1); monument is approx. 450 ft. south along Swiftwater Rd. across bridge over North Umpqua River.

SKETCH

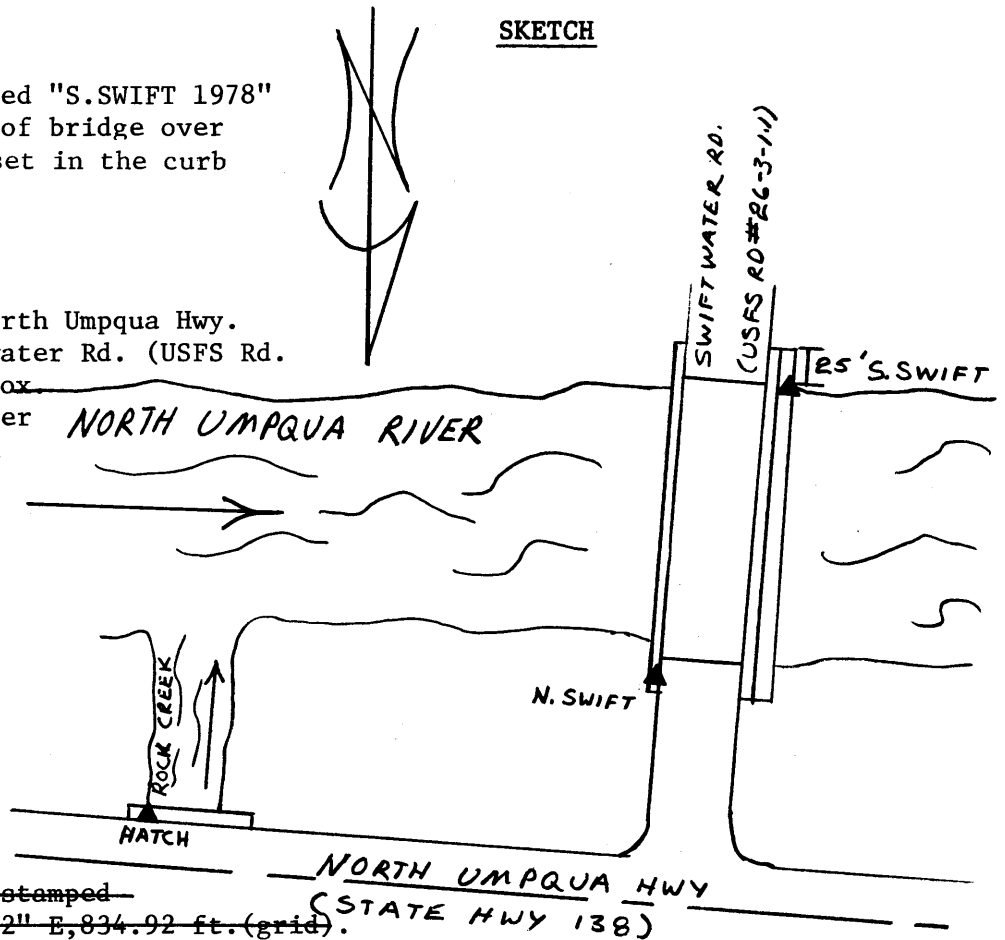

Reference Marks:

~~A Bureau of Pub. Roads disk stamped "HATCH 1978" bears N 64°44'22" E, 834.92 ft. (grid). (DESTROYED 12/03 PER DCSO)~~

A Fed. Hwy. Admin. disk stamped "N. SWIFT 1978" bears N 21°50'04" E, 373.78 ft. (grid).

Note: For further information, contact the Douglas County Surveyor's Office, Room 205 Douglas County Justice Building, Roseburg, OR 97470. Phone 440-4278. Douglas County residents outside the Roseburg calling area, dial toll free 1-800-452-0991.