

11/19/81
26S 4W 16

OFFICE OF THE

S-148
SUMMIT

DOUGLAS COUNTY SURVEYOR

NAD 606997.47 4210397.32
83 43°18' 4" 123°10'16"


T 26 S, R 4 W, Sec. 16

Station: SUMMIT

Set By (Agency): OSHD

Date: 1937

FD OK 5/99 DCSO

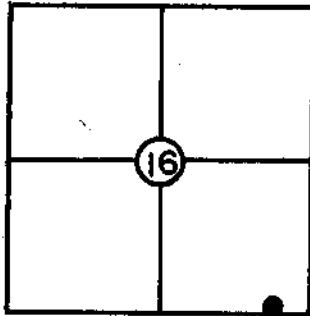

VERTICAL CONTROL

NGVD 29
Elevation: 785.917 NGS(USC&GS) Line # 94 USGS Line #

Order
Of Precision 1ST Agency: USC&GS Proj. #: CS66/37 Date: 1957

HORIZONTAL CONTROL

OCS 27
Oregon State Plane Coordinates: Y(Northing) 607,032.90 X(Easting) 1,289,437.54
(South Zone)

Order
Of Precision 1/25,000 Agency: DCSO Proj. #: 6012-12 CS61/13 Date: 1980


Approximate Geographic Position: Latitude= 43°18'04" Longitude= 123°10'11"

DESCRIPTION: Station is OSHD brass cap
set in concrete, stamped "SUMMIT 1937
ELEV 785 FT", with witness post along side.
See sketch for further info.

TO REACH: From mile post 11.9 along Co. Rd.
#4 at the intersection of Co. Rds. #223 &
#4 proceed NE'stly along #4 0.8 mi. to drive-
way on left. Station lies 5' right of drive-
way.

VICINITY: Approx. 13 mi. NE of Roseburg from
intersection of Old Hwy 99 and Co. Rd. #4

TELEPH. SKETCH

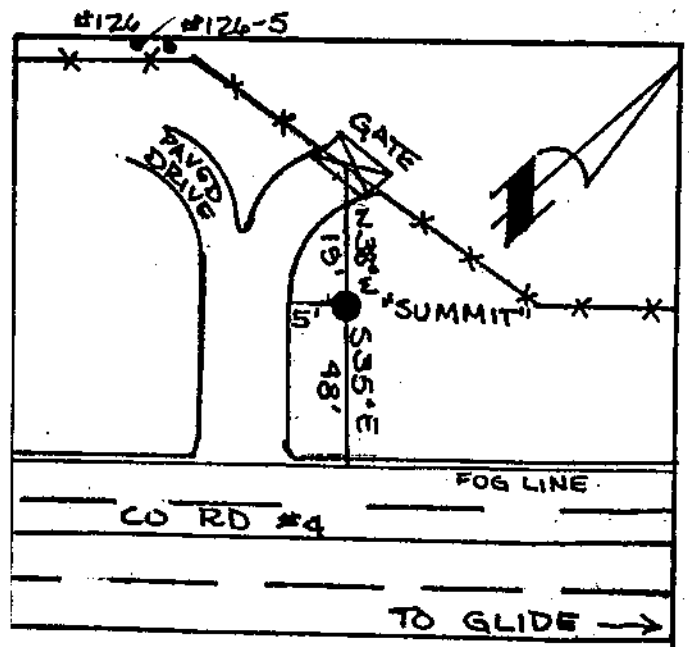

NOTE: For Possible Further Information On This Station, Please Contact The Douglas
County Surveyors Office, Rm. 205 Douglas County Justice Bldg., Roseburg, OR.
97470 Phone 672-3311 Ext. 272. Douglas County residents outside the
Roseburg calling area dial toll free 1-800-452-0991.