
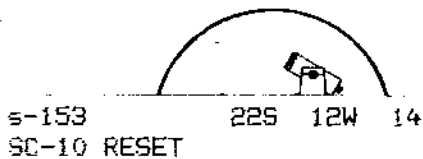


OFFICE OF THE
DOUGLAS COUNTY SURVEYOR

Station: SC-10 RESET
 Set By (Agency): DCSO
 Date Set: 1985
 Recovered By RWS, SJF
 Date Recovered 8/29/85
 Recovered By _____
 Date Recovered _____
 Recovered By _____
 Date Recovered _____

T 22 S, R 12 W, Sec 14

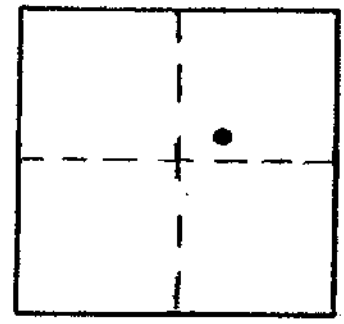

s-153 225 12W 14
 SC-10 RESET
 NAD 747931.00 3971715.02
 83 43°39'47" 124° 5'22"

VERTICAL CONTROL

Elevation: 19.839 NGS Line # _____ USGS Line # _____ OSHD Line # _____
 Precision: 2nd Agency: DCSO Proj. # 2006 Date: 1985

HORIZONTAL CONTROL

South Zone State Plane Coordinates: Y(Northing) 747,966.15 X(Easting) 1,050,754.22
 Precision: 1/25,000 Agency: DCSO Proj. # 2006 Date: 1985
 Approximate Geographic Position: Latitude 43°39'48" Longitude 124°05'18"

DESCRIPTION and TO REACH


SKETCH

DESCRIPTION:

A DCSO disk stamped "SC-10 RESET 1985"
 set in a 8 in. dia. concrete filled bell tile
 protruding 2 in. above ground.

TO REACH:

From the intersection of State Hwy. 38
 and Co. Rd.#55 (Scholfield Rd.) in
 T22S,R12W,Sec.1 proceed southerly along
 Scholfield Rd. 3.70 miles to monument
 on right.

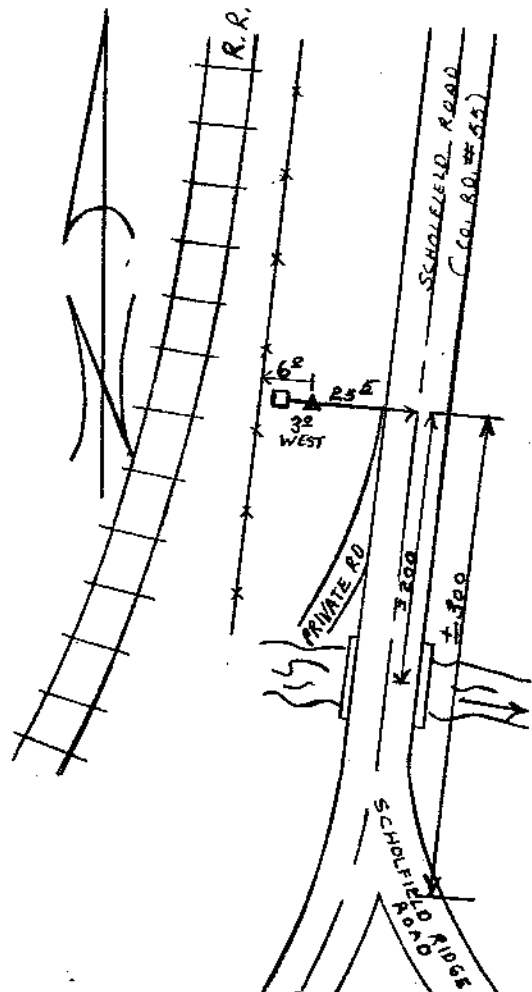

Reference Marks:

Note: For further information, contact the Douglas County Surveyor's Office, Room 205
 Douglas County Justice Building, Roseburg, OR 97470. Phone 440-4278. Douglas
 County residents outside the Roseburg calling area, dial toll free 1-800-452-0991.