


OFFICE OF THE
DOUGLAS COUNTY SURVEYOR

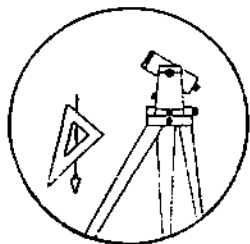

S-168

VERTICAL CONTROL

Elevation: _____ NGS Line # _____ USGS Line # _____ OSHD Line # _____
 Precision: _____ Agency: _____ Proj. # _____ Date: _____

HORIZONTAL CONTROL

South Zone O.C.S. 27: Y(Northing) _____ X(Easting) _____
 South Zone O.C.S. 83: Y(Northing) _____ X(Easting) _____
 Precision: _____ Agency: _____ Proj. # _____ Date: _____


Approx. ~~Geographic~~ Geographic Position: Latitude 43° 22' 36" Longitude 122° 39' 06"
 27

DESCRIPTION and TO REACH

SKETCH

Found: An OR DOT disk stamped "Stab GPS station 1989"
 Mon. is set in an 8" dia. concrete post flush with ground.

To Reach: From the intersection of St. Hwy 138 and Steamboat Rd.
 (Co. Rd. #249; becomes USFS Rd. #38) in T25S, R1E, sec. 32.
 Proceed northwesterly along Steamboat Creek (Co. Rd. #249 and USFS Rd. #38) Approx. 5.6 mi. to USFS Rd. #3810 and mon. on the right.

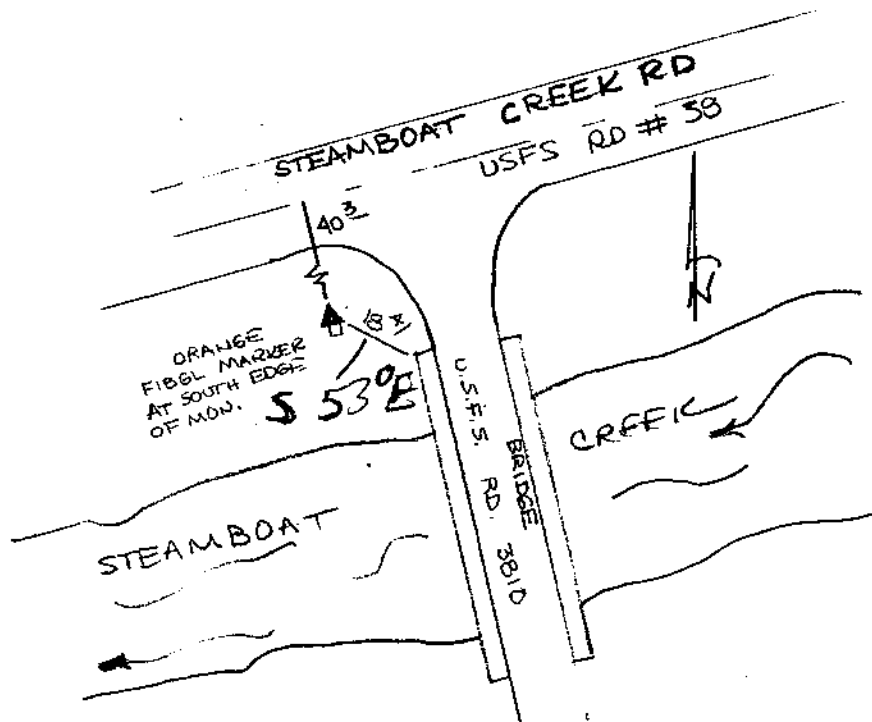

Reference Marks:

Note: For further information, contact the Douglas County Surveyor's Office, Room 205 Douglas County Justice Building, Roseburg, OR 97470. Phone 440-4278. Douglas County residents outside the Roseburg calling area, dial toll free 1-800-452-0991.

Station: STAB T 25 S, R 1E , Sec 26
 Date Set: 1989
 Set By (Agency): OR DOT
 Date Recovered: 8/9/91
 Recovered By: RWS-SJF
 Date Recovered: _____
 Recovered By: _____
 Date Recovered: _____
 Recovered By: _____

