
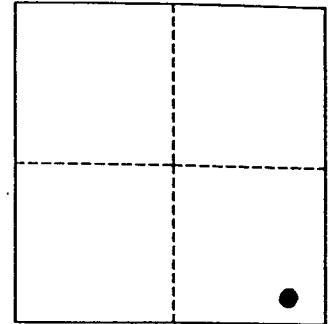


OFFICE OF THE
DOUGLAS COUNTY SURVEYOR

Station: S 738
 Date Set: 1987
 Set By (Agency): NGS
 DCSO Designation: S-172
 Date Recovered: 7-1993
 Recovered By: RWS S.JF
 Date Recovered: _____
 Recovered By: _____
 Date Recovered: _____
 Recovered By: _____

T21S R4W Sec. 10

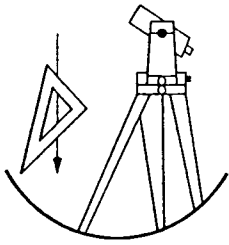

VERTICAL CONTROL

~~NGVD 29~~ ^{NAVD 88} Elevation: 592.146 FEET NAVD 88 Elevation: 180.486 METERS
 NGS Line # L25035 USGS LINE # _____ OSHD Line # _____ FILE # _____
 Precision: 1ST ORDER Agency: NGS Proj: _____ Date: 1988

HORIZONTAL CONTROL

O.C.S. 27 Y(Northing): _____ O.C.S. 83 Y(Northing): 771175
 (South Zone) X(Easting): _____ (South Zone) X(Easting): 4221120
 Precision: GIS SCALED Agency: DCSO Proj: _____ Date: 2014
 Approx. O.C.S. 27 Geographic Position: Latitude: 43°45'08" Longitude: 123°08'57"
 Approx. O.C.S. 83 Geographic Position: Latitude: _____ Longitude: _____

Found: A 3 - 5/8 inch diameter NGS disk stamped "S 738 1987" set vertically in rock face of a cut bank.

To reach: From the under crossing of Bear Creek Rd. (Co. Rd. #62) and I-5, i.e. exit 163, T21S R4W Sec19, proceed northerly along I-5 approx. 4.0 miles to mile point 167.35 and monument on left.

