

Station: STEPHEN


T 26 S, R 4W, Sec 18

Date Set: MAY 1999

Set By (Agency): DCSO


Date Recovered: 05/19/99

Recovered By: RWS, SJF

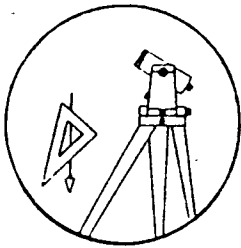

S-186

- Found
- New
- Reset
- Not Found
- Referenced
- Destroyed

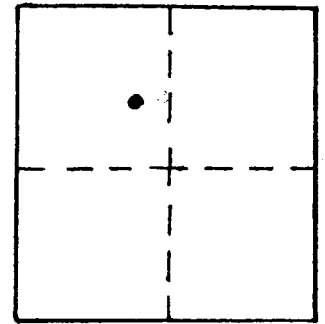

VERTICAL CONTROL

Elevation: 592.80 NGS Line # \_\_\_\_\_ USGS Line # \_\_\_\_\_ OSHD Line # \_\_\_\_\_

Precision: 3rd Agency: DCSO Proj. # 2007 Date: 1999

HORIZONTAL CONTROL CORPSCONG NAVD88 596.33 FT. CS 66/37

South Zone O.C.S. 27: Y(Northing) \_\_\_\_\_ X(Easting) \_\_\_\_\_

South Zone O.C.S. 83: Y(Northing) 611526 X(Easting) 4197336

Precision: GIS SCALED Agency: DCSO Proj. # \_\_\_\_\_ Date: 2014

Approx. NAD 83 Geographic Position: Latitude 43° 18' 45" Longitude 123° 13' 10"

DESCRIPTION and TO REACH

A 3 INCH DIAMETER DCSO DRILL CAP STAMPED "STEPHEN 1999" SET FLUSH IN SURFACE OF 16 FOOT WIDE, BY 100+ FOOT LONG, CONCRETE BOAT-RAMP. MONUMENT IS IN NORTH WEST CORNER AT HIGH END OF BOAT-RAMP

FROM THE ENTRANCE GATE OF WHISTLERS BEND PARK AT THE END OF WHISTLERS PARK ROAD (Co. Rd. #244) IN T 26 S, R 4W, SEC. 18 PROCEED NORTHERLY AND WESTERLY ALONG THE PARK ROAD APPROXIMATELY 0.80 MILES TO BOAT-RAMP AND MONUMENT ON LEFT.

Reference Marks:

NO SCALE:

