



Station: SKYLER
Date Set: 1999
Set By (Agency): DCSO
Date Recovered: 6-30-99
Recovered By: RWS SJF

T 26 S, R 3W, Sec 19

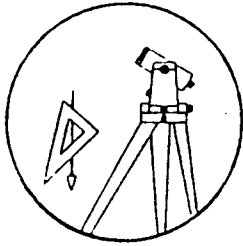

S-190

- Found
- New
- Reset
- Not Found
- Referenced
- Destroyed

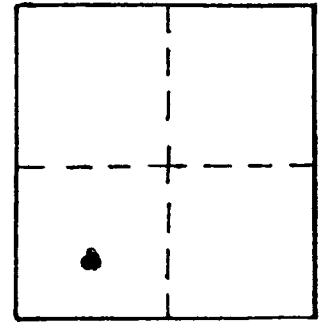

VERTICAL CONTROL

Elevation: 713.01 NGS Line # _____ USGS Line # _____ OSHD Line # _____

Precision: 3rd Agency: DCSO Proj. # 2007 Date: 1999

HORIZONTAL CONTROL CORPSCON6 NAVD88 716.57 FT. CS66156

South Zone O.C.S. 27: Y(Northing) _____ X(Easting) _____

South Zone O.C.S. 83: Y(Northing) 602324 X(Easting) 4228561

Precision: GIS SCALED Agency: DCSO Proj. # _____ Date: 2014

Approx. ⁰⁰⁵²⁷~~NAD 83~~ Geographic Position: Latitude 43° 17' 24" Longitude 123° 06' 04"

DESCRIPTION and TO REACH

DCSO BRASS CAP STAMPED "SKYLER 1999"
SET A CONCRETE CURB.

FROM THE INTERSECTION OF DIAMOND LAKE
HWY (ST. HWY 138) AND LITTLE RIVER RD
(CORP #170) IN T26 S R3 W SEC. 30 PROCEED
SOUTHEASTERLY ALONG LITTLE RIVER ROAD 0.5 MILES
TO MONUMENT ON RIGHT

Reference Marks:

