

OFFICE OF THE
DOUGLAS COUNTY SURVEYOR

Station: SCOTTY


T 27 S, R 2, Sec 8

Date Set: 1999

Set By (Agency): DCSO


Date Recovered: 7-6-99

Recovered By: RWS SJF

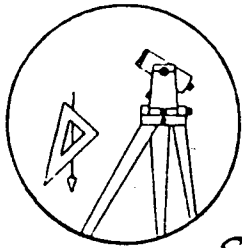

S-191

- Found
- New
- Reset
- Not Found
- Referenced
- Destroyed

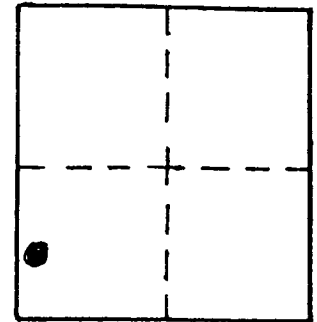

VERTICAL CONTROL

Elevation: 1007.45 NGS Line # _____ USGS Line # _____ OSHD Line # _____

Precision: 3rd Agency: DCSO Proj. # 2007 Date: 1999

HORIZONTAL CONTROL CORPSCON6 NAVDBB 1011.10 FT. CS 66/56

South Zone O.C.S. 27: Y(Northing) _____ X(Easting) _____

South Zone O.C.S. 83: Y(Northing) 580189 X(Easting) 4262870

Precision: GIS SCALED Agency: DCSO Proj. # _____ Date: 2014

Approx. ^{DCS 27} ~~NAD 83~~ Geographic Position: Latitude 43°13'55" Longitude 122°58'11"

DESCRIPTION and TO REACH

DCSO BRASS CAP STAMPED "SCOTTY 1999"
SET IN SOUTHEAST CORNER OF NORTHERLY CONCRETE
FOUNDATION OF PRIVATE FOOT BRIDGE OVER
LITTLE RIVER

FROM THE INTERSECTION OF LITTLE RIVER ROAD
(CO. RD #17C) AND NEW BRIDGE ROAD (CO. RD #2A)
IN T27S, R3W SEC 11 PROCEED SOUTH-
EASTERLY ALONG LITTLE RIVER ROAD
2.25 MILES TO PRIVATE BRIDGE AND MONUMENT
ON RIGHT.

Reference Marks:

