

DOUGLAS COUNTY SURVEYOR'S OFFICE

R073020A


100-1180

Designation: S-206 Station: SMITH - 4 T21S R11W S20 1/4 NE

Date Set: 7-22-03 Set by (Agency): DCSG

Date Recovered: 7-22-03 Recovered by: RUS SJF

- Found, Not Found, New, Referenced, Reset, Destroyed

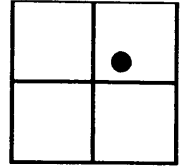

VERTICAL CONTROL


NGVD 29 Elevation: 13.87 Feet File # CS 67/05
Precision: 3rd Agency: DCSG Project: 2006 Date: 2003
NAVD 88 Elevation: Meters File #
Precision: Agency: Project: Date:

HORIZONTAL CONTROL - south zone

N E Datum/Adj.: 1927 Precision: 615
Lat: 43°44'03.4" Long: 124°01'59.2" Agency: DCSG File # R013020A Date: 2003
N E Datum/Adj.: Precision:
Lat: Long: Agency: File # Date:
N E Datum/Adj.: Precision:
Lat: Long: Agency: File # Date:
N E Datum/Adj.: Precision:
Lat: Long: Agency: File # Date:

DESCRIPTION AND TO REACH

DCSG DRILL CAP STAMPED
"SMITH-4 2003" SET IN
SOUTHEAST WING WALL OF
CONCRETE BRIDGE OVER
OTTER CREEK
GO TO THE INTERSECTION
OF SOUTH SMITH RIVER RD.
(CO. RD #195) AND OTTER
SLOUGH ROAD (CO. RD #119)
IN T21S R11W SEC 20

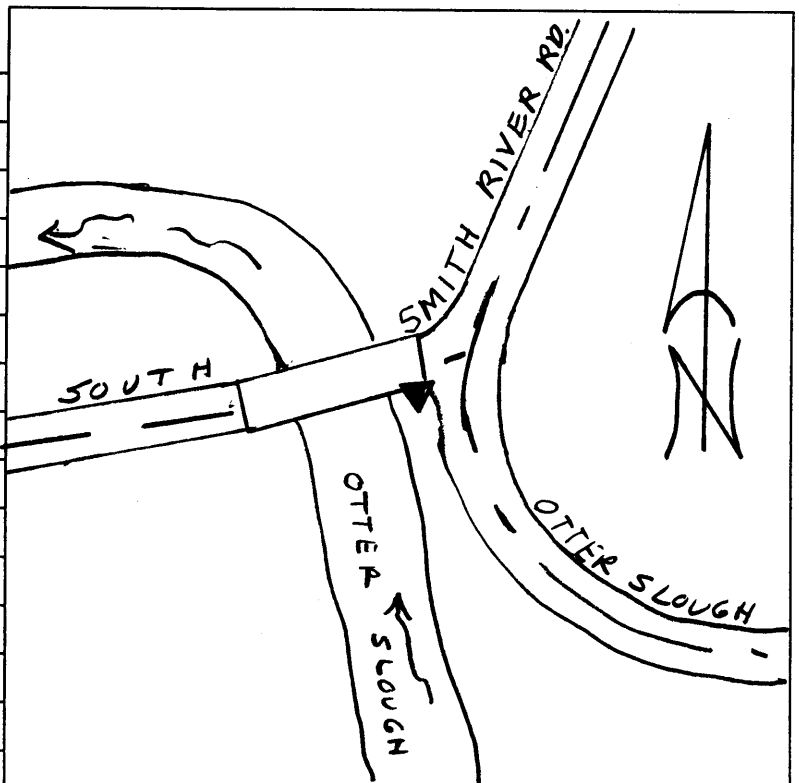



7. 30. 2003